


Ellsworth

KANSAS

Section 32 Township 17 Range 10-W

Well No. 1 Dougherty


Company Transwestern

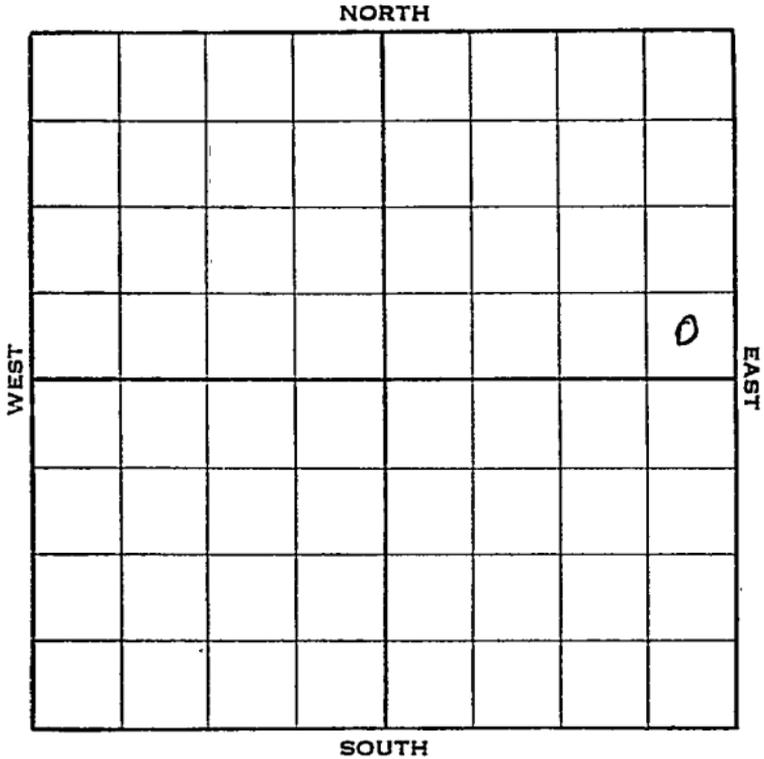

Sec. 32 Twp. 17 R. 10-W

Well No. #1 Dougherty Farm
Transwestern Company

_____ Ft. from N. Line
330 Ft. from S. Line
330 Ft. from E. Line
 _____ Ft. from W. Line

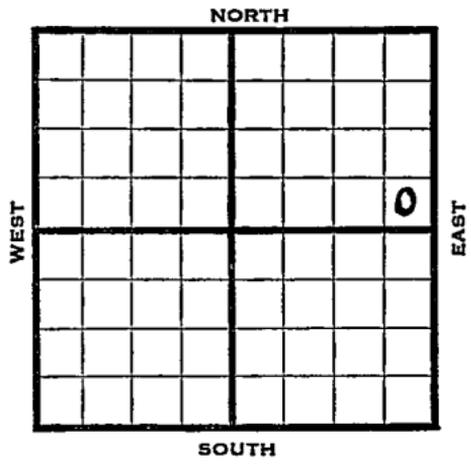

Elev. 1795'

1938	REPORT
9/21	B. R. R.
9/30	10" - 259'. Anhy 530'.
	Dlg. 1032'.
10/7	Drlg. 2730'.
10/14	Arb. 3258'. 7" - 3260'.
	T. D. 3275'. 2200' oil 5 hrs.
	2900' oil 11 hrs. No water.
10/20	Potential 1102 natural (Tel)
10/19	7" - 3260'.
	Arb. 3258'.
	T. D. 3275'.
	Potential 1102 bbls. Nat'l.
	COMPLETED

Map No. 55 Sec. 32 Twp. 17 R. 10W

Well No. 1 Dougherty

Transwestern Company

Contractor

FIRST REPORT

SE NE

Ft. from N. Line

330 Ft. from S. Line

330 Ft. from E. Line

Ft. from W. Line

SECTION PLAT

			0

Location _____

Rig up _____

Drilling and Remarks:

BRR

RECORD

Cased _____ in., _____ ft.

Sand _____

Gas _____

Oil _____

Total Depth _____

PRODUCTION

1st 24 hrs. Nat. _____

1st 24 hrs. after shot _____

Gas _____ Cu. Ft.

Dry Hole _____

Abandoned _____

Date

SEP 21 1938

19

H. D. Hatfield

Scout

Ellsworth **KANSAS**

Map No. _____ Sec. 32 Twp. 17 R. 10W

Well No. 1 Dougherty

Transwestern Company

COMPLETED

Contractor _____

SE NE

SECTION PLAT

_____ Ft. from N. Line

330 Ft. from S. Line

330 Ft. from E. Line

_____ Ft. from W. Line

			0

Location _____

Rig up _____

Drilling and Remarks:

POT 1102
NAT

RECORD

Cased 7 in., 3260 ft.

Sand Arb 3258

Gas _____

Oil _____

Total Depth 3275

PRODUCTION

1st 24 hrs. Nat. _____

1st 24 hrs. after shot _____

Gas _____ Cu. Ft.

Dry Hole _____

Abandoned _____

Date
OCT 19 1938

H. D. Hatfield

19

Scout