

KANSAS


Ellsworth

FORM 51 5M 1-42 PETROL

Section 32 Township 17 Range 10-W

Well No. #1 C. J. Stumps "B"

Company Western Pet. Exploration

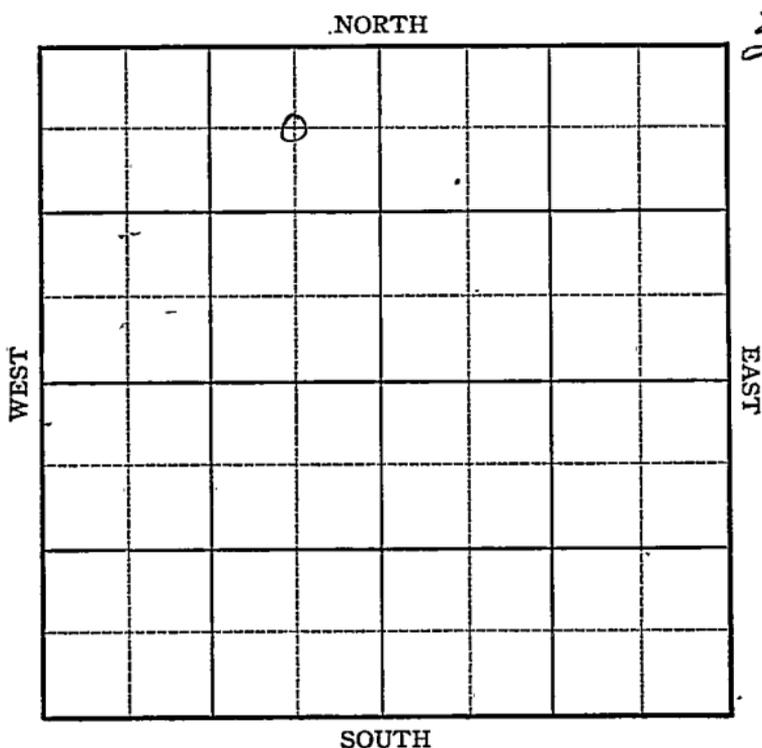

Sec. 32 Twp. 17 R. 10-W

Well No. #1 C. J. Stumps "B" Farm

Western Petroleum Company

Bloomer


660 Ft. from N. Line

_____ Ft. from S. Line

660 Ft. from E. Line

_____ Ft. from W. Line

Elev. 1794

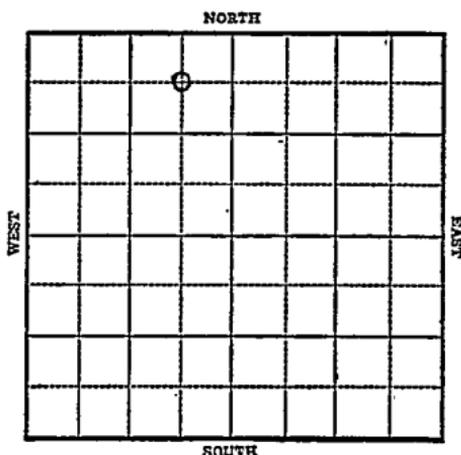

1943

R E P O R T

3/31	12" @ 212'
	10" @ 235'
	Drlg. 2875'
4/7	Arb 3244
	7" @ 3244
	T.D. 3256 Sat. Rust.
4/14	" " " "
4/21	" " " "
4/28	T.D. 3276
	500' oil 12 hrs-1000 acid
	Pump 14 oil 1 hr.
5/5	" " " "
5/12	" " " "
5/19	Arb. 3244
	7" - 3244
	1000 acid
	Pump 104 Pot.
	T.D. 3276
	Gravity 42.6

COMPLETED

KANSAS

Ellsworth

Map No. 55 Sec. 32 Twp. 17 R. 10W

Well No. 1 C. J. Stumps "B"

Western Petroleum Company

FIRST REPORT Exploration Contractor

C NE NW


SECTION PLAT

660 Ft. from N. Line

_____ Ft. from S. Line

660 Ft. from E. Line

_____ Ft. from W. Line

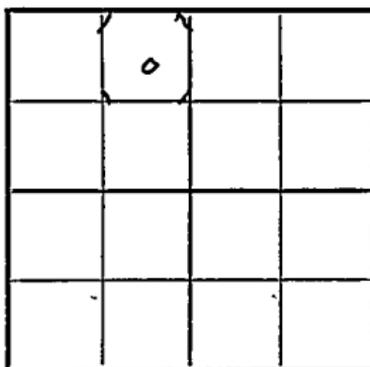

BLOOMER POOL

Location _____

Rig up _____

Drilling and Remarks:

12" - 212'

10" - 235'

Dr1g. 2875'

RECORD

Cased _____ in., _____ ft.

Sand _____

Gas _____

Oil _____

Total Depth _____

PRODUCTION

1st 24 hrs. Nat.: _____

1st 24 hrs. after shot _____

Gas _____ Cu. Ft.

Dry Hole _____

Abandoned _____

Date

MAR 31 1943

19

S. J. LEWIS

Scout

KANSAS

Map No. 35 Sec. 32 Twp. 17 R. 10W

Well No. 1 C. J. Stumps "B"

Western Petroleum Company Exploration

COMPLETED

Contractor

C NE NW

SECTION PLAT

660 Ft. from N. Line

_____ Ft. from S. Line

660 Ft. from E. Line

_____ Ft. from W. Line

	0		

BLOOMER POOL

Location _____

Rig up _____

Drilling and Remarks:

Cor 3244
2" @ 3244
1000 acid
Pump 104 B

42 6/8

RECORD

Cased _____ in., _____ ft.

Sand _____

Gas _____

Oil _____

Total Depth 3276

PRODUCTION

1st 24 hrs. Nat. _____

1st 24 hrs. after shot _____

Gas _____ Cu. Ft.

Dry Hole _____

Abandoned _____

Date

MAY 1 9 1943 19

S. J. LEWIS Scout