


Section 32 Township 17 Range 10-W

Well No. 1 - Zink

Company Skelly Oil

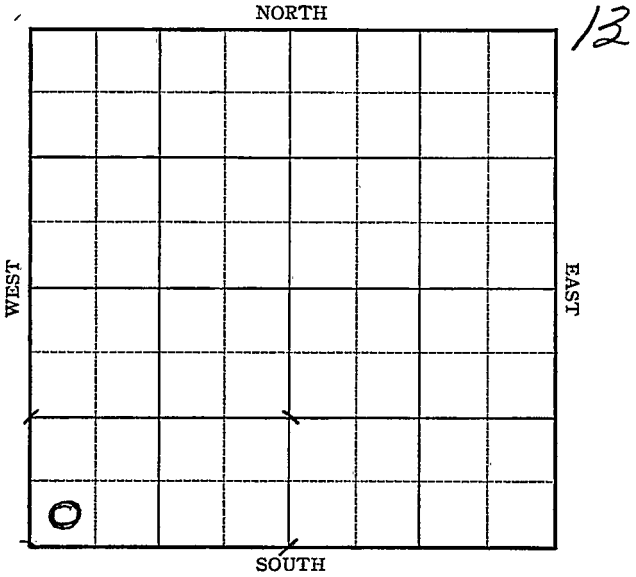

Sec. 32 Twp. 17 R. 10-W

Well No. #1 Zink Farm \_\_\_\_\_  
Skelly Oil Company \_\_\_\_\_


\_\_\_\_\_ Ft. from N. Line

330 Ft. from S. Line

\_\_\_\_\_ Ft. from E. Line

330 Ft. from W. Line

Elev. 1784

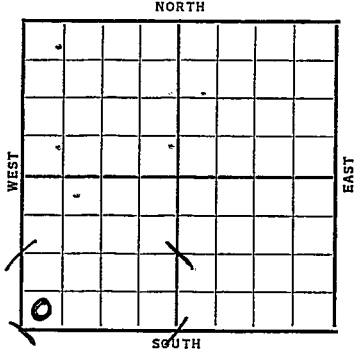

Date	REPORT
1937	
9/1	Location
9/10	R. R.
9/17	13" @ 207'. Drlg. 414'.
9/24	Drlg. 2210'.
10/2	K.C. 2934'. S.O. & G 3000-05'.
	7" @ 3000'. RUST.
10/8	T.D. 3018 Flow 257 bbls. in 7 hrs.
	1 1/4 M Gas 6000 acid
10/9	Flowed 1,267 bbls. first 4 hours
	Down 45 minutes Next 4 hours flowed
	1359 bbls. Gas Gauged 6,810,000
	24 hour potential 7,604 bbls. (Tel)
	<b>OVER</b>

1937

10/13 7" @ 3000'.

K.C. 2934'.

T.D. 3018".

6000 acid.

Flowed 1267 bbls. 4 hrs. Down 45 Min.

Flowed 1660 bbls. 4 hrs.

Potential 7604 oil.

6,810,000 cu. ft. gas.

COMPLETED

**KANSAS**

*Ellsworth*

Map No. \_\_\_\_\_ Sec. 32 Twp. 17 R. 10W

Well No. 1 - Link

Skelly Oil Company  
 \_\_\_\_\_ Contractor

**FIRST REPORT**

**SECTION PLAT**

\_\_\_\_\_ Ft. from N. Line

330 Ft. from S. Line

\_\_\_\_\_ Ft. from E. Line

330 Ft. from W. Line


Location

Rig up \_\_\_\_\_

Drilling and Remarks:

**RECORD**

Cased \_\_\_\_\_ in., \_\_\_\_\_ ft.

Sand \_\_\_\_\_

Gas \_\_\_\_\_

Oil \_\_\_\_\_

Total Depth \_\_\_\_\_

**PRODUCTION**

1st 24 hrs. Nat. \_\_\_\_\_

1st 24 hrs. after shot \_\_\_\_\_

Gas \_\_\_\_\_ Cu. Ft.

Dry Hole \_\_\_\_\_

Abandoned \_\_\_\_\_

Date

SEP 1 1937 19

H. D. Hatfield Scout

Ellsworth **KANSAS**

Map No. \_\_\_\_\_ Sec. 32 Twp. 17 R. 10W

Well No. 1 Zink

Skelly Oil Company

Contractor \_\_\_\_\_

**COMPLETED**

SW/C

\_\_\_\_\_ Ft. from N. Line

330 Ft. from S. Line

\_\_\_\_\_ Ft. from E. Line

330 Ft. from W. Line

**SECTION PLAT**


Location \_\_\_\_\_

Rig up \_\_\_\_\_

Drilling and Remarks:

*6000 acid*

*Flowed → 1267 / 4 hrs (DOWN 45 MIN)*  
*→ 1660 / 4*

*POT - 7604 oil*  
*6,810,000 gals*

**RECORD**

Cased 7 in., 3000 ft.

Sand A.C., 2934

Gas \_\_\_\_\_

Oil \_\_\_\_\_

Total Depth 3018

**PRODUCTION**

1st 24 hrs. Nat. \_\_\_\_\_

1st 24 hrs. after shot \_\_\_\_\_

Gas \_\_\_\_\_ Cu. Ft.

Dry Hole \_\_\_\_\_

Abandoned \_\_\_\_\_

Date

OCT 13 1937 19

H. D. Hatfield Scout