Formation Completion
Affidavit
Deliver Report
Conservation Division
State Corporation Commission
212 No. Market
Wichita, Kansas

State Geology
WICHITA, BRANCH

WELL PLUGGING RECORD

30-16s-16w

15-165-20515

Rush County. Sec. 30 Twp. 16S Rge. 16 (E) (W)

Location as "NE/CNWKSWK" or footage from lines C-NW-NE

Lease Owner Empire Oil

Lease Name Ochs Well No. 2

Office Address 1720 Wichita Plaza

Character of Well (completed as Oil, Gas or Dry Hole) Oil

Date well completed 2-18 19 75

Application for plugging filed 2-19 19 75

Application for plugging approved 2-20 19 75

Plugging commenced 2-26 19 75


Plugging completed 2-26 19 75

Reason for abandonment of well or producing formation Non-Commercial

If a producing well is abandoned, date of last production 0 19

Was permission obtained from the Conservation Division or its agents before plugging was commenced? Yes

NORTH

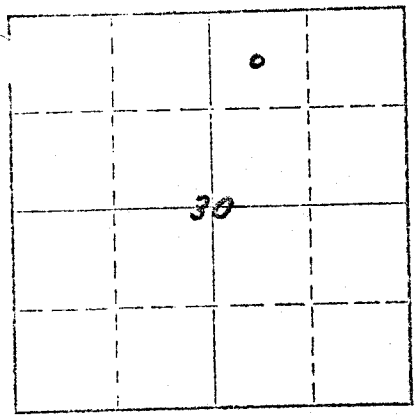

Locate well correctly on above Section Plat

Name of Conservation Agent who supervised plugging of this well Lea Massey

Producing formation Lans-KC Depth to top 3286 Bottom 3519 Total Depth of Well 3577 Feet

Show depth and thickness of all water, oil and gas formations.

OIL, CAS OR WATER RECORDS — CASING RECORD

FORMATION	CONTENT	FROM	TO	SIZE	PUT IN	PULLED OUT
		0	220'	8 5/8"	220'	0
		0	3570	4 1/2	3570'	3050'

Describe in detail the manner in which the well was plugged, indicating where the mud fluid was placed and the method or methods used in introducing it into the hole. If cement or other plugs were used, state the character of same and depth placed, from feet to feet for each plug set.

Set wire line plug at 3400'. Shot off @ 3050' and pulled 3050' 4½" pipe.

Mixed 20 sacks of gel mud and 3 sacks hulls followed by 120 sacks cement.

Max press. 1000#. Shut in press. 250#.

RECEIVED
APR 1975
STATE GEOLOGICAL SURVEY OF KANSAS

(If additional description is necessary, use BACK of this sheet)

Name of Plugging Contractor Allied Cementing, Inc.

Russell, Ks.