


Woodson

Form 51-5M-2-29-34703

Map No. KANSAS Sec. 18 Twp. 24 R. 14

Well No. 2-2-20000 Farm

Gates Oil Company

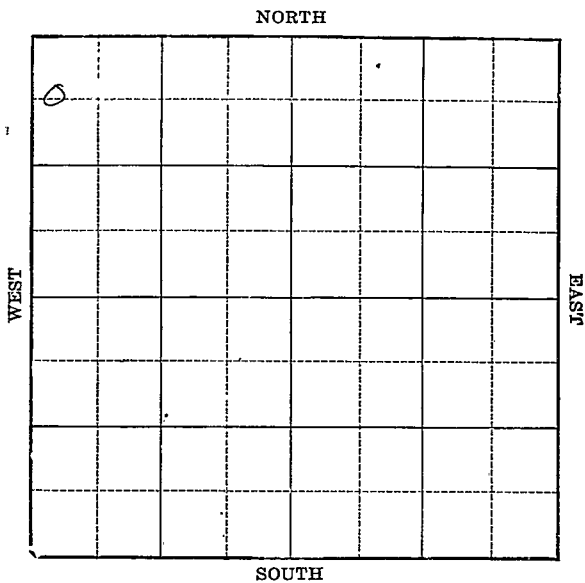

Location \_\_\_\_\_

Drilling Remarks \_\_\_\_\_

\_\_\_\_\_

\_\_\_\_\_

Rig Up \_\_\_\_\_

Drilling Remarks \_\_\_\_\_

\_\_\_\_\_

\_\_\_\_\_

RECORD

Cased \_\_\_\_\_ in. \_\_\_\_\_ ft.

Sand \_\_\_\_\_

Gas \_\_\_\_\_

Oil \_\_\_\_\_

Total Depth \_\_\_\_\_

PRODUCTION

1st 24 hrs. Nat. \_\_\_\_\_

1st 24 hrs. after shot \_\_\_\_\_

Gas \_\_\_\_\_ cu. ft. \_\_\_\_\_

Dry Hole \_\_\_\_\_

Abandoned \_\_\_\_\_

*Woodson*

MAP No. *Ans* SEC. *18* TWP. *74* R. *14*

WELL No. *2* *Kimball*

*Sales Oil Co* COMPANY

CONTRACTOR

**FIRST REPORTS  
COMPLETED**

**SECTION PLAT**

<i>0</i>			

FT. FROM N. LINE

FT. FROM S. LINE

FT. FROM E. LINE

FT. FROM W. LINE

LOCATION \_\_\_\_\_

RIG UP \_\_\_\_\_

DRILLING AND REMARKS:

*No record of  
Production*

**RECORD**

CASED \_\_\_\_\_ IN. \_\_\_\_\_ FT.

SAND *1618-1624*

GAS \_\_\_\_\_

OIL \_\_\_\_\_

TOTAL DEPTH *1624*

**PRODUCTION**

1ST 24 HRS. NAT. \_\_\_\_\_

1ST 24 HRS. AFTER SHOT \_\_\_\_\_

GAS \_\_\_\_\_ CU. FT.

DRY HOLE \_\_\_\_\_

ABANDONED \_\_\_\_\_

DATE \_\_\_\_\_

*Sherwood*