

Woodson


Form 51-5M-2-29-34703

Map No. KANSAS Sec. 18 Twp. 24 R. 14

Well No. 2- Gimball Farm

Sullespilstal Company

NORTH

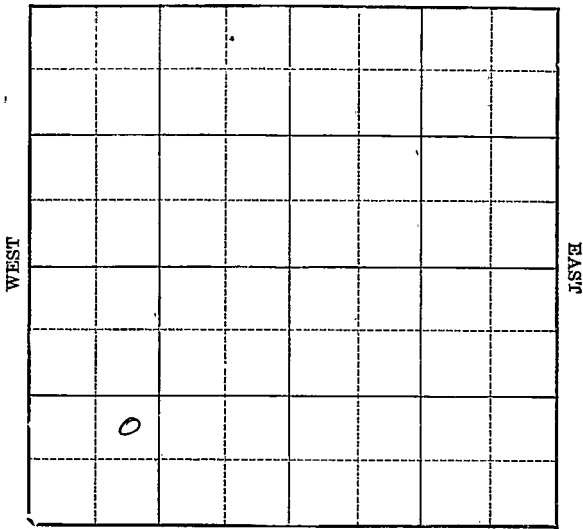

SOUTH

Location _____

Drilling Remarks _____

Rig Up _____

Drilling Remarks _____

RECORD

Cased _____ in. _____ ft.

Sand _____

Gas _____

Oil _____

Total Depth _____

PRODUCTION

1st 24 hrs. Nat. _____

1st 24 hrs. after shot _____

Gas _____ cu. ft.

Dry Hole _____

Abandoned _____

Woodson

MAP NO. *Kns* SEC. *18* TWP. *24* R. *14*

WELL NO. *2 Kimball*
Gillespie Oil COMPANY

CONTRACTOR

**FIRST REPORTS
 COMPLETED**

SECTION PLAT

_____ FT. FROM N. LINE
 _____ FT. FROM S. LINE
 _____ FT. FROM E. LINE
 _____ FT. FROM W. LINE

<i>0</i>			

RECORD

LOCATION _____

CASED _____ IN. _____ FT.

RIG UP _____

SAND *1641-1652*

DRILLING AND REMARKS:

GAS _____

OIL _____

TOTAL DEPTH *1652*

PRODUCTION

1ST 24 HRS. NAT. _____

1ST 24 HRS. AFTER SHOT _____

GAS *1.11* CU. FT.

DRY HOLE _____

ABANDONED _____

DATE

11/28/21

192

Sherwood

SCOUT