

Woodson

Form 51-5M-2-29-34703

Map No. KANSAS Sec.

18 Twp. 24 R. 14

Well No. 95-


Kimball

Farm

Gates Oil

Company

NORTH

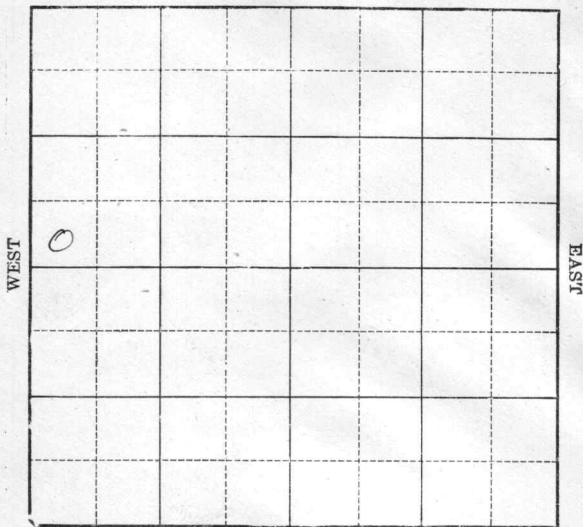

SOUTH

Location

Drilling Remarks

Rig Up

Drilling Remarks

RECORD

Cased in. ft.

Sand

Gas

Oil

Total Depth

PRODUCTION

1st 24 hrs. Nat.

1st 24 hrs. after shot

Gas cu. ft.

Dry Hole

Abandoned

Woodson

MAP No. *Kus* SEC. *18* TWP. *24* R. *14*

WELL No. *5 Kimball*
Gates Oil Co COMPANY

CONTRACTOR

FIRST REPORTS
COMPLETED

SECTION PLAT

_____ FT. FROM N. LINE
700 FT. FROM S. LINE
_____ FT. FROM E. LINE
700 FT. FROM W. LINE

<i>0</i>			

LOCATION _____

RIG UP _____

DRILLING AND REMARKS:

PB to 1677'
Water 1677-83'

115 Bb.

RECORD

CASED _____ IN.
SAND *1677-83*
GAS _____
OIL _____
TOTAL DEPTH *1683*

PRODUCTION

1ST 24 HRS. NAT. _____
1ST 24 HRS. AFTER SHOT _____
GAS _____ CU. FT.
DRY HOLE _____
ABANDONED _____

DATE

12/1/21 192

Shenwood

SCOUT