


KANSAS

Map No. _____ Sec. 9 Twp. 29 R. 4
 Well No. 1-Patterson Farm _____
Ohio Oil Company

NORTH

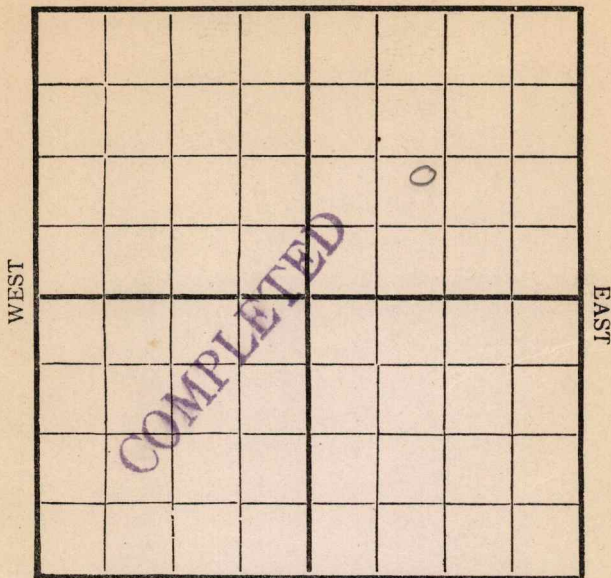

SOUTH

Location _____

Rig Up 1-27-17

Drilling Remarks:

Drilling Remarks:

RECORD

PRODUCTION

Cased _____ in _____ Ft.

1st 24 hrs. Nat. _____

Sand _____

1st 24 hrs. after shot _____

Gas _____

Gas _____ Cu. Ft.

Oil _____


Dry Hole _____

Total Depth _____

Abandoned _____

BUTLERMap No. 11 Sec. 9 Twp. 29 R. 4Well No. 1 Patterson FarmOhio Ice Company

NORTH

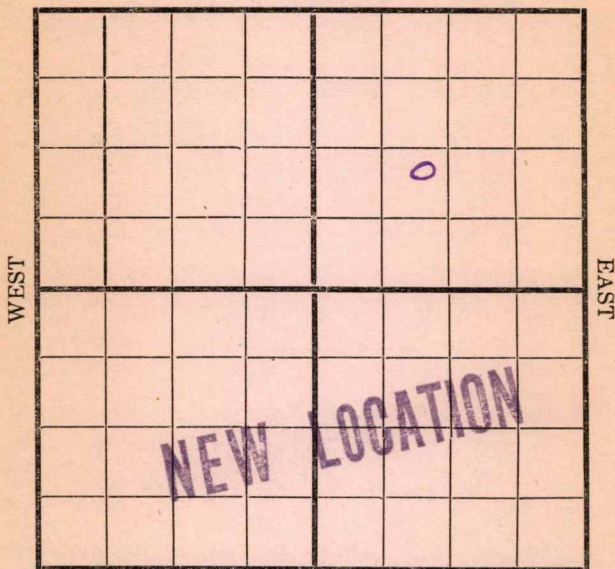

SOUTH

Location _____

Rig Up ☒ _____

Drilling and remarks _____

RECORD

Cased _____ in. _____ Ft.

Sand _____

Gas _____

Oil _____

Total Depth _____

PRODUCTION

1st 24 hrs. Nat. _____

1st 24 hrs. after shot _____

Gas _____ Cu. Ft.

Dry Hole _____

Abandoned _____

Date

JAN 27 1917

_____, 191_____

E. H. WEST


Scout

Butler
 Map No. _____ Sec. 9 Twp. 29 R. 4
 Well No. 1 Patterson Farm _____
 _____ Ohio Company _____

NORTH

WEST

EAST

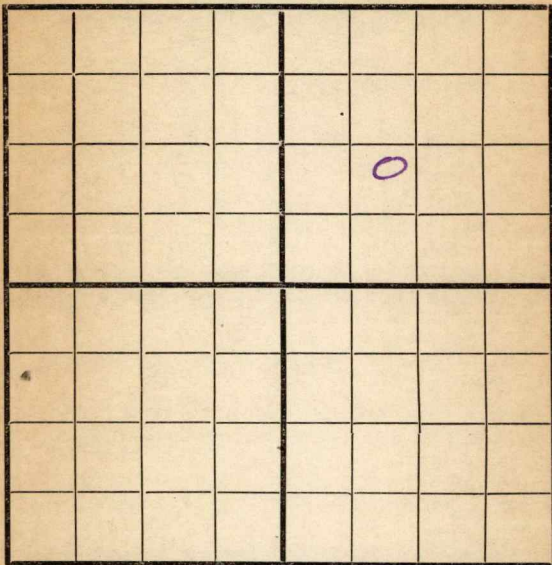

SOUTH

Location _____
 Rig Up ✓ _____
 Drilling and remarks _____

RECORD

Cased _____ in. _____ Ft.
 Sand _____
 Gas _____
 Oil _____
 Total Depth _____

PRODUCTION

1st 24 hrs. Nat. _____
 1st 24 hrs. after shot _____
 Gas _____ Cu. Ft.
 Dry Hole _____
 Abandoned _____

Date

FEB - 3 1917

191

Scout

E. H. WEST


Butler

Map No. _____ Sec. 9 Twp. 29 R. 4Well No. 1 Patterson FarmOhio Company

NORTH

WEST

EAST

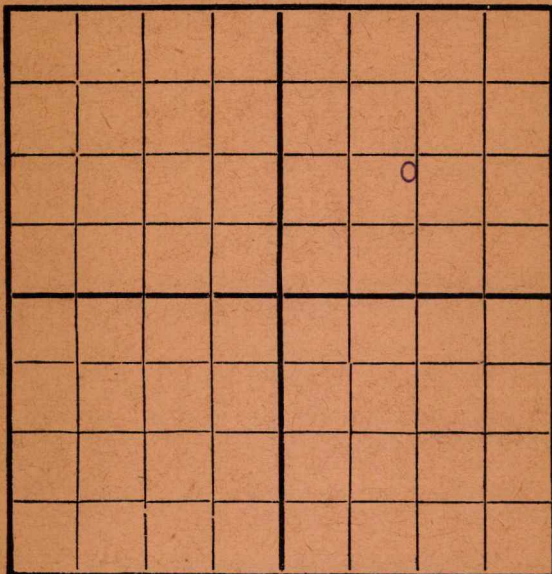

SOUTH

Location _____

Rig Up _____

Drilling and remarks

Spudding

RECORD

Cased _____ in. _____ Ft.

Sand _____

Gas _____

Oil _____

Total Depth _____

PRODUCTION

1st 24 hrs. Nat. _____

First 24 hrs. after shot _____

Gas _____ Cu. Ft.

Dry Hole _____

Abandoned _____

Date

FEB 10 1917


191

E. H. WEST

Scout

Map No. _____ Sec. 9 Twp. 29 R. 4
 Well No. 1 Patterson Farm _____
 _____ Ohio Oil Company

NORTH

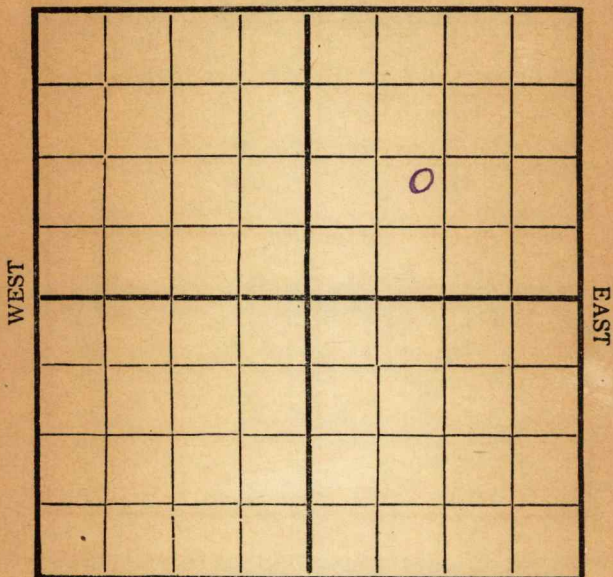

SOUTH

Location _____
 Rig Up _____
 Drilling and remarks _____

D-400

RECORD

Cased _____ in. _____ Ft.
 Sand _____
 Gas _____
 Oil _____
 Total Depth _____

PRODUCTION

1st 24 hrs. Nat. _____
 First 24 hrs. after shot _____
 Gas _____ Cu. Ft.
 Dry Hole _____
 Abandoned _____

Date

FEB 17 1917

191


O. J. Proctor Scout

Butler

Map No. _____ Sec. *9* Twp. *29* R. *4*

Well No. *1 Patterson* _____ Farm

_____ *Ohio Oil* _____ Company

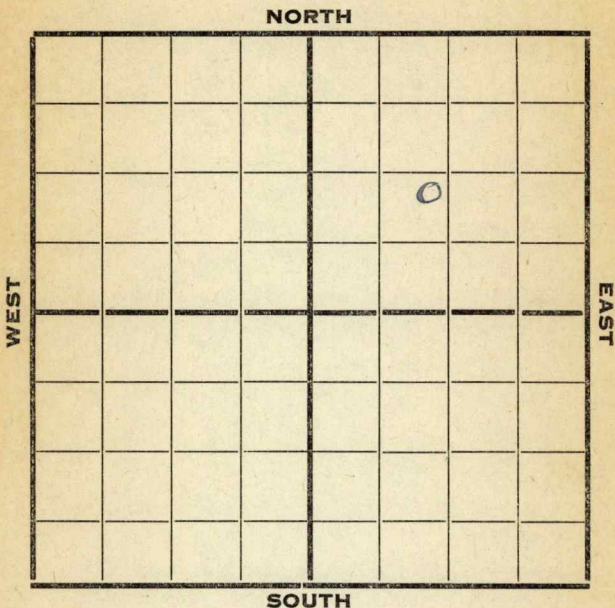

Location _____

Rig up _____

Drilling and Remarks:

D. 1250

RECORD

Cased _____ in. _____ Ft.

Sand _____

Gas _____

Oil _____

Total Depth _____

PRODUCTION

1st 24 hrs. Nat. _____

1st 24 hrs. after shot _____

Gas _____ Cu. Ft.

Dry Hole _____

Abandoned _____

Date

FEB 24 1917

191


C. J. Crocker

Scout

BUTLER

Map No. _____ Sec. 9 Twp. 29 R. 4Well No. 1 Patterson FarmOhio Oil Company

NORTH

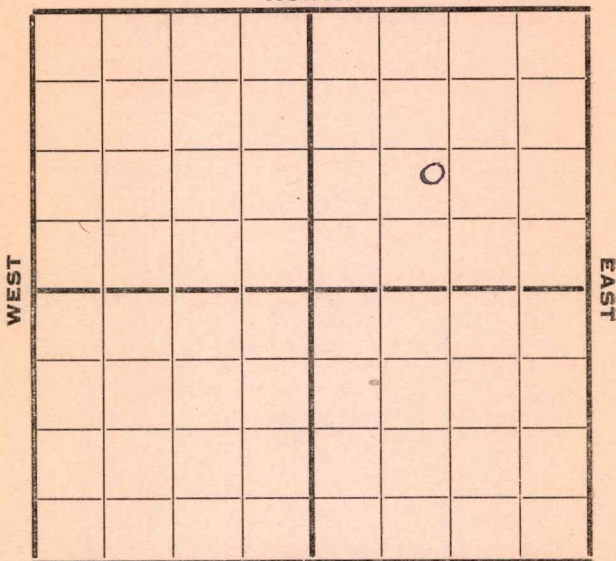

SOUTH

Location _____

Rig up _____

Drilling and Remarks:

Q. 1410

RECORD

Cased _____ in. _____ Ft.

Sand _____

Gas _____

Oil _____

Total Depth _____

PRODUCTION

1st 24 hrs. Nat. _____

1st 24 hrs. after shot _____

Gas _____ Cu. Ft.

Dry Hole _____

Abandoned _____

Date

MAR 3 1917


191

E. J. Crocker

Scout

Map No. _____ Sec. 9 Twp. 29 R. 4Well No. 1 Patterson FarmOhio Oil Company

NORTH

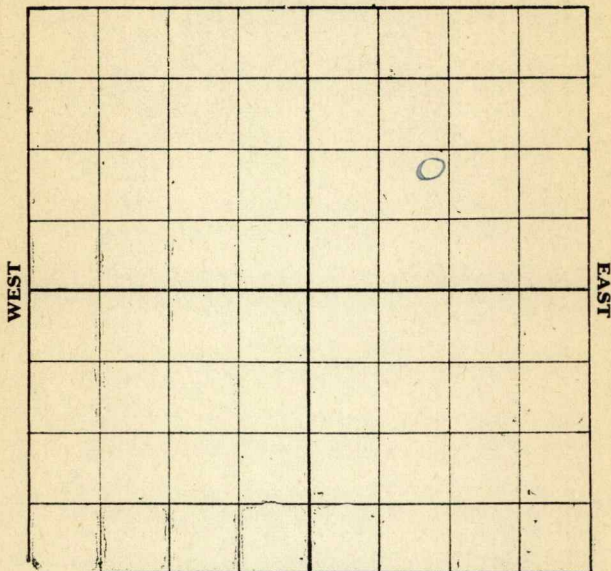

SOUTH

RECORD

Location _____

Cased _____ in. _____ Ft.

Rig up _____

Sand _____

Drilling and Remarks:

Gas _____

Oil _____

Total Depth _____

PRODUCTION

1st 24 hrs. Nat. _____

1st 24 hrs. after shot _____

Gas _____ Cu. Ft.

Dry Hole _____

Abandoned _____

Date

3/10, 1917, E. J. Crocker Scout


S.D. 1781
Top of sand 1770
Good showing
of Oil.

Map No. _____ Sec. 9 Twp. 29 R. 4Well No. 1 Patterson FarmOhio Oil Company

NORTH

WEST

EAST

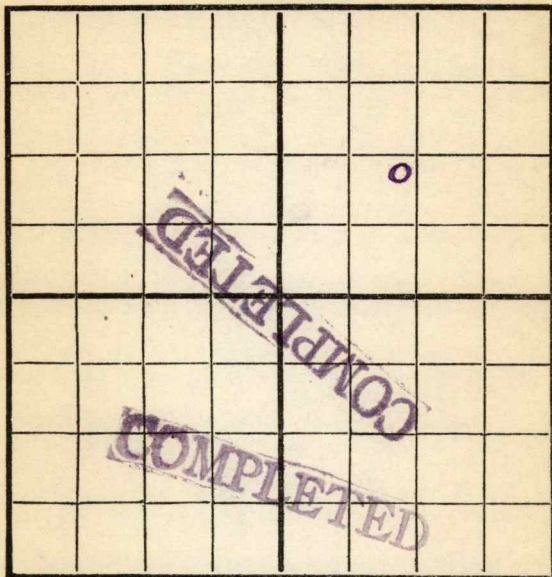

SOUTH

Location _____

Rig Up _____

Drilling and remarks _____

RECORD

Cased _____ in. _____ Ft.

Sand 1770-1792

Gas _____

Oil _____

Total Depth 1792

PRODUCTION

1st 24 hrs. Nat. 2,000

1st 24 hrs. after shot _____

Gas _____ Cu. Ft.

Dry Hole _____

Abandoned _____

Date

MAR 17 1917

191

C. J. Crocker Scout