


Map No. KANSAS Sec. 18 Twp. 24 R. 14E

Well No. 5-Kinnel Farm _____

Lako Company _____

Woodson

NORTH

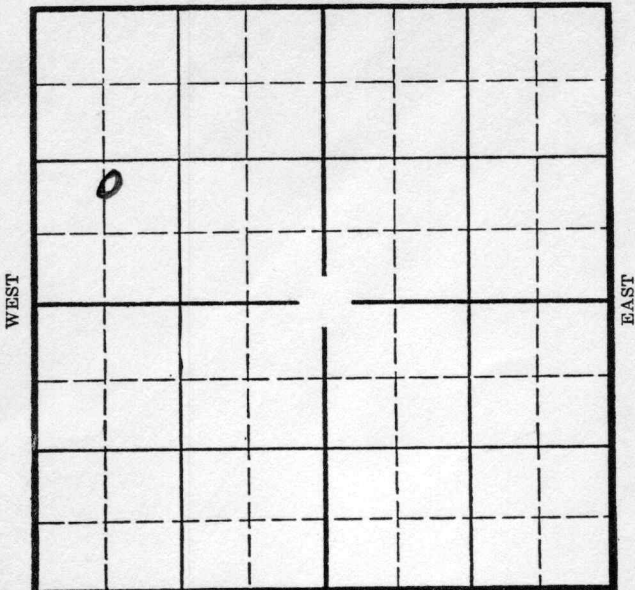

SOUTH

Location _____

Drilling Remarks _____

Rig Up _____

Drilling Remarks _____

RECORD

Cased _____ in. _____ ft.

Sand _____

Gas _____

Oil _____

Total Depth _____

PRODUCTION

1st 24 hrs. Nat. _____

1st 24 hrs. after shot _____

Gas _____ cu. ft. _____

Dry Hole _____

Abandoned _____

Woodson
24 R. 14E

Map No. KANSAS Sec. 18 Twp. 24 R. 14E

Well No. 5-Kimmel Farm


Oeko Company

_____ Ft. from N. Line

1120 Ft. from S. Line

_____ Ft. from E. Line

685 Ft. from W. Line

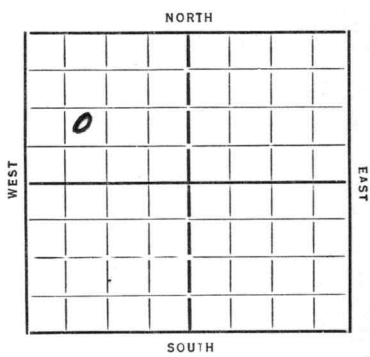

Date	REPORT
7/3/35	
6/26	dely 675
7/3	" 920
7/10	TL 1631
	oil 1668-73
	T7 1678
	12 oil
	20 Water
	COMPLETED

Map No. 17 Sec. 18 Twp. 24 R. 14E

Well No. 5 Kimmel

Dakota Company

Contractor

SECTION PLAT

..... Ft. from N. Line

1120 Ft. from S. Line

..... Ft. from E. Line

685 Ft. from W. Line

o			

FIRST REPORTS

Location.....

Rig up.....

Drilling and Remarks:

Drill 675

RECORD

Cased..... in., ft.

Sand.....

Gas.....

Oil.....

Total Depth.....

PRODUCTION

1st 24 hrs. Nat.....

1st 24 hrs. after shot.....

Gas..... Cu. Ft.

Dry Hole.....

Abandoned.....

Date

6/26/35 192

ORVAL MANNSCHECK

Scout

Map No. 17 Sec. 18 Twp. 24 R. 14 E

Well No. 5-Kimel

oko oil

Company

Contractor

COMPLETED

SECTION PLAT

0			

Ft. from N. Line

1120 Ft. from S. Line

Ft. from E. Line

685 Ft. from W. Line

Location

Rig up

Drilling and Remarks:

12 oil
20 water

RECORD

Cased in ft.

Sand TL 1631

Gas

Oil 1668-73

Total Depth 1678

PRODUCTION

1st 24 hrs. Nat.

1st 24 hrs. after shot

Gas Cu. Ft.

Dry Hole

Abandoned

Date

7-10-35 192

ORVAL MANNSCHECK

Scout