


KANSAS

Map No. _____ Sec. 9 Twp. 29 R. 4
 Well No. #6 Patterson Farm
Ohio _____ Company

NORTH

WEST

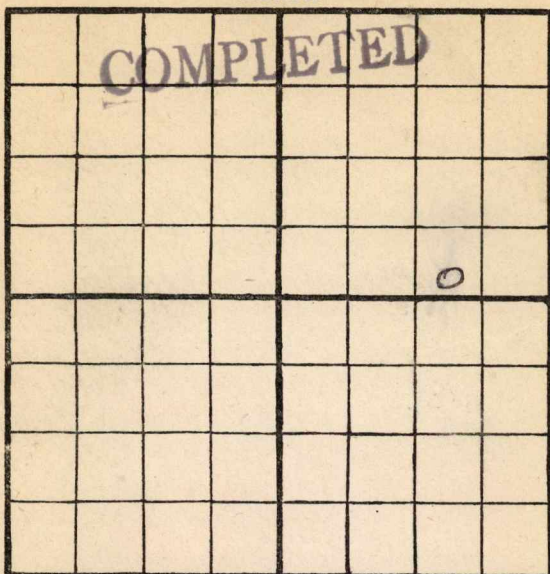

EAST

SOUTH

Location _____

Rig Up _____

Drilling Remarks:

Drilling Remarks:

RECORD

PRODUCTION

Cased _____ in. _____ ft.

1st 24 hrs. Nat. _____

Sand _____

1st 24 hrs. after shot _____

Gas _____

Gas _____ cu. ft

Oil _____

Dry Hole _____


Total Depth _____

Abandoned _____

Map No. K-11 Sec. 9 Twp. 29 R. 4
 Well No. 6 Patterson Farm
Ohio Company

NORTH

WEST

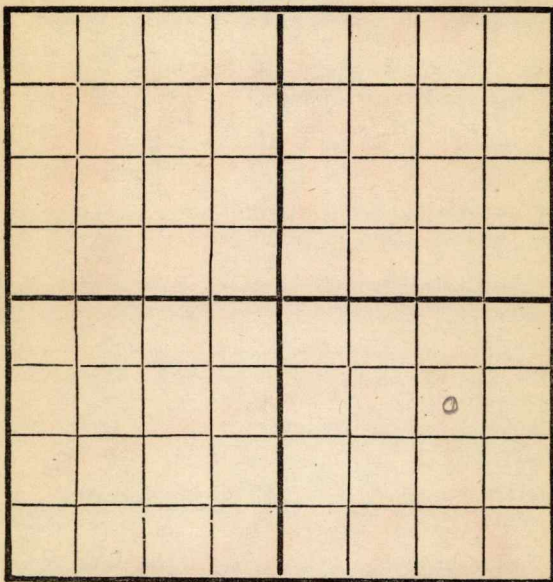

EAST

SOUTH

Location -----

Rig Up -----

Drilling and remarks

990' N 7 E
 330 N 7 S

First Report

RECORD

Cased ----- in. ----- Ft.

Sand -----

Gas -----

Oil -----

Total Depth -----

PRODUCTION

1st 24 hrs. Nat. -----

1st 24 hrs. after shot -----

Gas ----- Cu. Ft.

Dry Hole -----


Abandoned -----

Date

6/12, 1912, Conley Scout

Map No. _____ Sec. 9 Twp. 29 R. 4
 Well No. 6 Patterson Farm _____
Ohio Company _____

NORTH

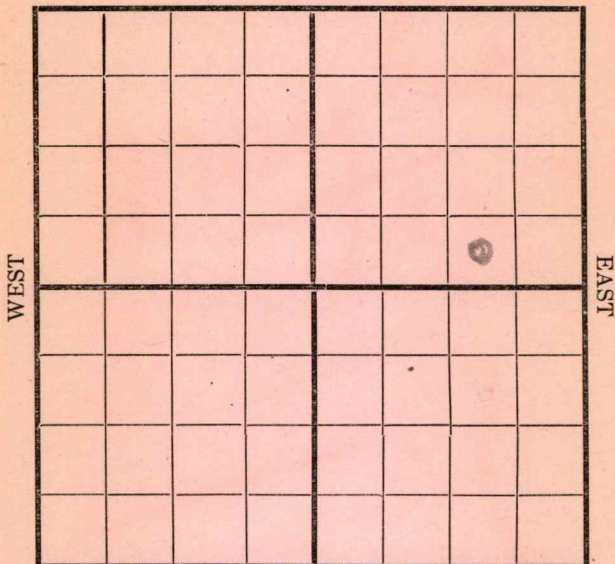

SOUTH

Location _____

Rig Up _____

Drilling and remarks

1150

RECORD

Cased _____ in. _____ Ft.

Sand _____

Gas _____

Oil _____

Total Depth _____

PRODUCTION

1st 24 hrs. Nat. _____

1st 24 hrs. after shot _____

Gas _____ Cu. Ft.

Dry Hole _____

Abandoned _____

Date


7/6, 1917 Cordiff Scout

Map No. _____ Sec. 9 Twp. 29 R. 4Well No. 6 Patterson Farm _____Ohio Company _____

NORTH

WEST

EAST

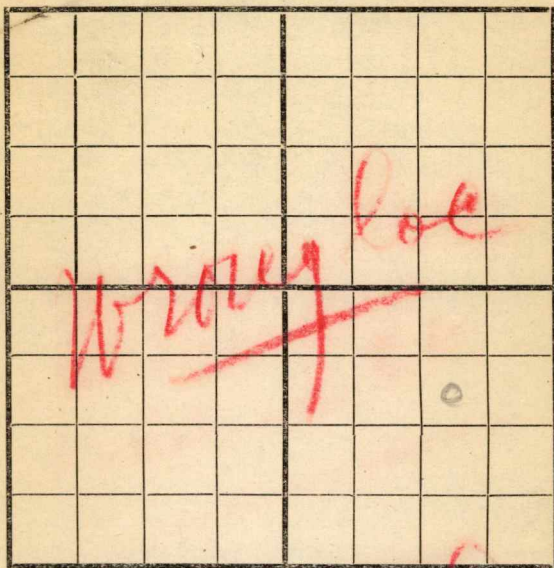

SOUTH

Location _____

Rig Up _____

Drilling and remarks _____

RECORD

Cased _____ in. _____ Ft.

Sand _____

Gas _____

Oil _____

Total Depth _____

PRODUCTION

1st 24 hrs. Nat. _____

1st 24 hrs. after shot _____

Gas _____ Cu. Ft.

Dry Hole _____


Abandoned _____

Date

6/20, 1917 Cardiff Scout

Map No. _____ Sec. 9 Twp. 29 R. 4
 Well No. 6 Patterson Farm _____
Oliver Company _____

NORTH

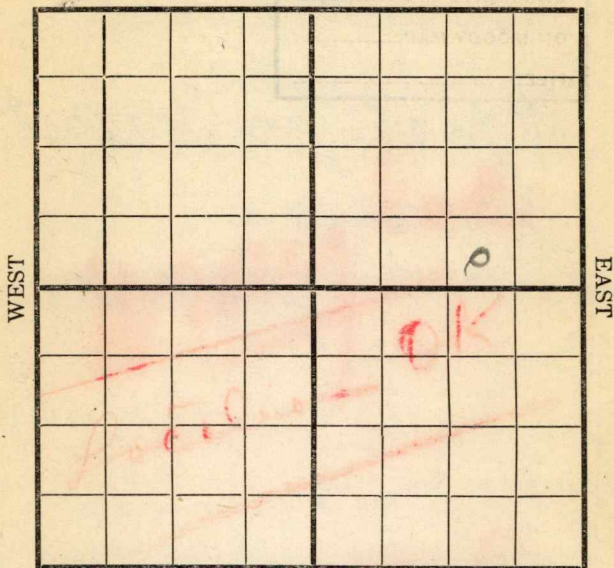

SOUTH

Location _____

Rig Up _____

Drilling and remarks

500

RECORD

Cased _____ in. _____ Ft.

Sand _____

Gas _____

Oil _____

Total Depth _____

PRODUCTION

1st 24 hrs. Nat. _____

1st 24 hrs. after shot _____

Gas _____ Cu. Ft.

Dry Hole _____

Abandoned _____


Date

6/27, 191 7 Conley Scout

RETURNED BY.....
ON TRACING <i>mm</i>
ON J. S. C. MAP.....
ON FRANTZ MAP <i>Box</i>
ON MOODY MAP.....
FILED.....

*Which is Correct
location*

RHK

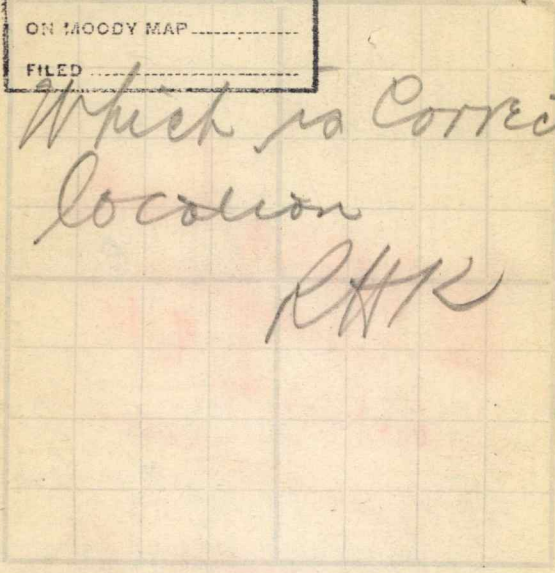

SOUTH


RECORD	Location
Caseh	Rin Up
Sand	Drilling and remarks
Gas	
Oil	
Total Depth	
PRODUCTION	
1st 24 hrs. Net	
1st 24 hrs. after shot	
Gas	
Dry Hole	
Abandoned	

Date

Map No. K-11 Sec. 9 Twp. 29 R. 4Well No. 6 Patterson Farm
Ohio Company

NORTH

WEST

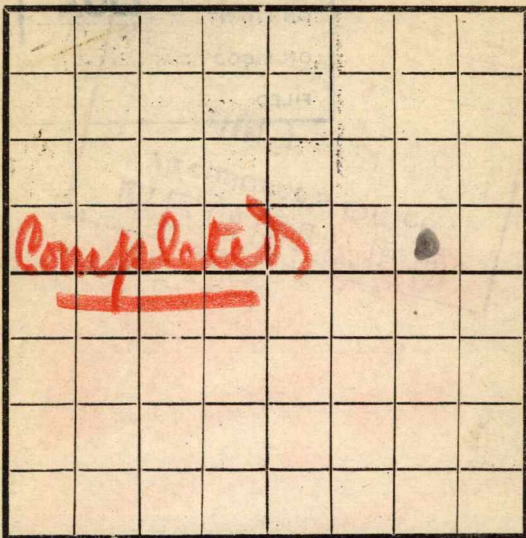

EAST

SOUTH

Location -----

Rig Up -----

Drilling and remarks

Est at
200 Bbls

RECORD

Cased ----- in. ----- Ft.

Sand 1793-1808

Gas -----

Oil -----

Total Depth -----

PRODUCTION

1st 24 hrs. Nat. -----

1st 24 hrs. after shot -----

Gas ----- Cu. Ft.

Dry Hole -----


Abandoned -----

Date

7/12, 1917 Condy Scout

Map No. **K14** Sec. **9** Twp. **29** R. **4**Well No. _____ Farm _____
Company _____

NORTH

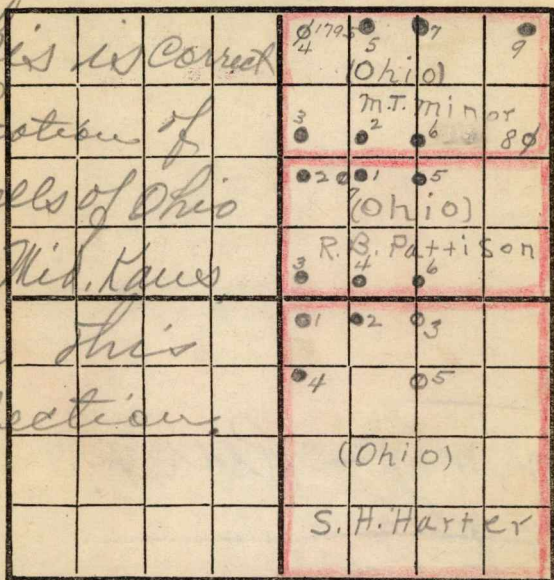

SOUTH

Location _____

Rig Up _____

Drilling and remarks

PLEASE
make changes
on map.
Lantz

RECORD

Cased _____ in. _____ Ft.

Sand _____

Gas _____

Oil _____

Total Depth _____

PRODUCTION

1st 24 hrs. Nat. _____

1st 24 hrs. after shot _____

Gas _____ Cu. Ft.

Dry Hole _____

Abandoned _____

Date

_____, 191_____, _____ Scout

Tickets attached
shown correct
Locations

on map - Rump
on J.S.C.

on Frantz map
on Waddy map


Location	Drilling and remarks	Ref. Up
Gas		
Oil		
Total Depth		
PRODUCTION		
1st 24 hrs. Nat.		
1st 24 hrs. after start		
Gas		
Dry Hole		
Abandoned		
Date		
101		
Scout		

Map No. _____ Sec. 9 Twp. 29 R. 4Well No. 60 Patterson FarmOhio _____ Company

NORTH

WEST

EAST

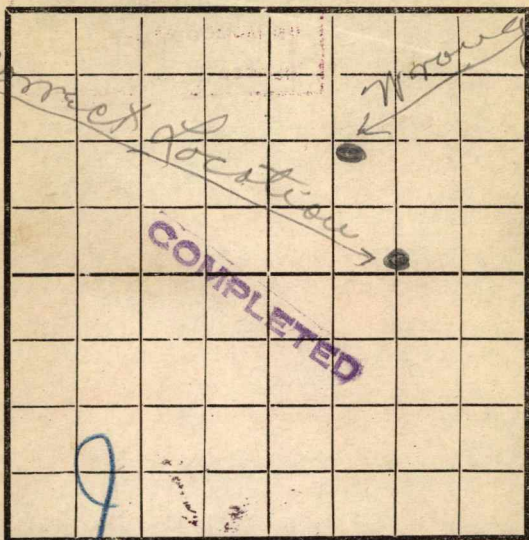

SOUTH

RECORD

Cased _____ in _____ Ft.

Sand 1793-1802

Gas _____

Oil ☒Total Depth 1802

PRODUCTION

1st 24 hrs. Nat. 200 Bbls

1st 24 hrs. after shot _____

Gas _____ Cu. Ft.

Dry Hole _____

Abandoned _____

Location _____

Rig Up _____

Drilling and remarks

There is only
one #6.
Ohio is
owner of this
lease.

Date

8-20, 1917 Lantz Scout