


Section 18 Township 24 Range 14-E

Well No. 14 Kimball

Company Woodson Pipe Line

NORTH Winterscheid Pool

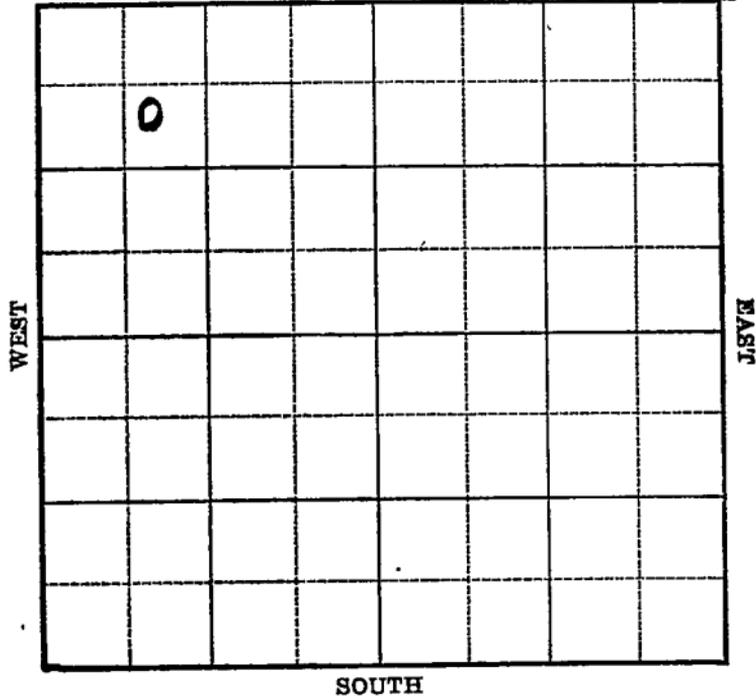

Sec. 18 Twp. 24 R. 14-E

Well No. #14 Kimball Farm _____

Woodson Pipe Line Company _____


(Winterscheid)

750 Ft. from N. Line

_____ Ft. from S. Line

_____ Ft. from E. Line

750 Ft. from W. Line

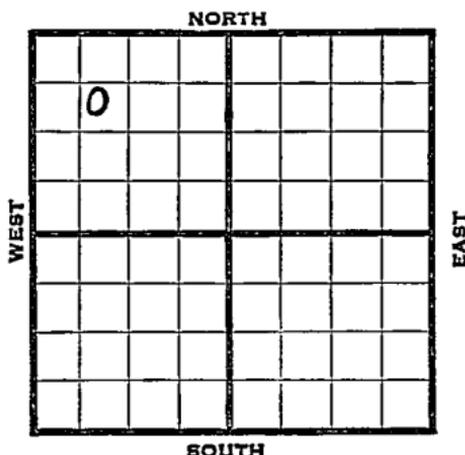

1939	' REPORT
3/22	Drlg. 600'
3/31	" "
4/7	8" - 771' 6" - 1114'
	Miss. 1625' 5" - 1630'
	T. D. 1658' 200' oil.
	3000 acid.
4/12	5" - 1630'
	Miss. 1625'
	T. D. 1658'
	3000 acid.
	Potential 10 bbls. No water.
	COMPLETED

Map No. 17 Sec. 18 Twp. 24 R. 14EWell No. 14 KimballWoodson Pipe Line

Company

Contractor

FIRST REPORT

SECTION PLAT

Approx.
750 SE NW NW
Ft. from N. Line

____ Ft. from S. Line

____ Ft. from E. Line

750 Ft. from W. Line

WINTERSCHIED POOL

Location _____

Rig up _____

Drilling and Remarks:

Drlg. 600

RECORD

Cased _____ in., _____ ft.

Sand _____

* Gas _____

Oil _____

Total Depth _____

PRODUCTION

1st 24 hrs. Nat. _____

1st 24 hrs. after shot _____

Gas _____ Cu. Ft.

Dry Hole _____

Abandoned _____

Date

MAR 22 1939 19

H. D. Hatfield

Scout

Map No. 17 Sec. 18 Twp. 24 R. 14EWell No. 14 KimballWoodson Pipe Line Company

Contractor

COMPLETED

Approx.

SE NW NW

750 Ft. from N. Line

_____ Ft. from S. Line

_____ Ft. from E. Line

750 Ft. from W. Line

SECTION PLAT

0			

WINTERSCHEID POOL

Location _____

Rig up _____

Drilling and Remarks:

3000 AcidPot 10 bbls
no wtr

RECORD

Cased 5 in. 1630 ft.Sand MISS 1625

Gas _____

Oil _____

Total Depth 1658

PRODUCTION

1st 24 hrs. Nat. _____

1st 24 hrs. after shot _____

Gas _____ Cu. Ft.

Dry Hole _____

Abandoned _____

Date

APR 12 1939 19H. D. Hatfield Scout