


Map No. 19 24 R. 14E
 Well No. 1- Kimball Farm
Spencer stab Company

NORTH

WEST

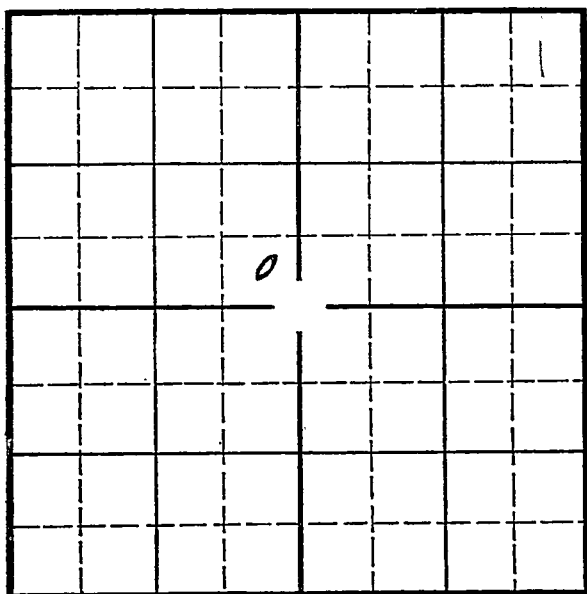

EAST

SOUTH

Location _____

Drilling Remarks _____

Rig Up _____

Drilling Remarks _____

RECORD

Cased _____ in. _____ ft.

Sand _____

Gas _____

Oil _____

Total Depth _____

PRODUCTION

1st 24 hrs. Nat. _____

1st 24 hrs. after shot _____

Gas _____ cu. ft. _____

Dry Hole _____

Abandoned _____

Woodson

Map No. KANSAS Sec. 19 Twp. 24 R. 14E


Well No. Kimball Farm
Spencer Stab Company

 Ft. from N. Line

330 Ft. from S. Line

330 Ft. from E. Line

 Ft. from W. Line

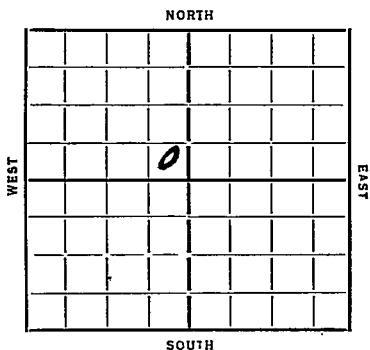

REPORT	
7/17	Machine
8/8	Spur & S.D.
8/15	8/22 - 8/29 - 9/6 -
10/3	10/10 - 11/6 - 11/7 - 11/14 -
11/21	11/29 - 12/6 -
12/13	Qty 700
12/19	955
12/26	12/36 -
1/10	Qty 1585
1/17	TD 1585 SD
1/22	Miss 1659
	See Sho Oil 1672
	Water 1681-86
	TD 1686
	D. & H.
	ABANDONED

KANSAS

Map No. 17 Sec. 19 Twp. 24 R. 14EWell No. 1-KimballSpencer et al Company

Contractor

FIRST REPORTS

SECTION PLAT

Ft. from N. Line

330 Ft. from S. Line330 Ft. from E. Line

Ft. from W. Line

Location.....

Rig up.....

Drilling and Remarks:

Machin

RECORD

Cased.....in.,ft.

Sand.....

Gas.....

Oil.....

Total Depth.....

PRODUCTION

1st 24 hrs. Nat.....

1st 24 hrs. after shot.....

Gas.....Cu. Ft.

Dry Hole.....

Abandoned.....

Date

7-17-36 192W. H. HARRISON Scout

Map No. 17 Sec. 19 Twp. 24 R. 14E

Well No. 1 - Kimball

Spencer et al Company

Contractor

SECTION PLAT

Ft. from N. Line

330 Ft. from S. Line

330 Ft. from E. Line

Ft. from W. Line

COMPLETED

	0		

Location

Rig up

Drilling and Remarks:

Sm. Sho. oil 1672
water 1681-86

O + A

RECORD

Cased _____ in., _____ ft.

Sand MISS 1659

Gas _____

Oil _____

Total Depth 1686

PRODUCTION

1st 24 hrs. Nat. _____

1st 24 hrs. after shot _____

Gas _____ Cu. Ft.

Dry Hole _____

Abandoned _____

Date

JAN 22 1936

Scout

C. V. L. MANN SCHRECK