

Thompson Drilling Co., Inc.
 425 South 26th Street
 Independence, Kansas 67301
 (316) 331-3092

API No. 15 - 205 - 24,529
 County Number

Operator
 Kelt Oil & Gas Inc.
 Address
 900 College Ave. Independence, Kansas 67301

Well No. **PECKAP #177** Lease Name **PECKAP**
Wilson field

Footage Location
 1155 Ft North from Southeast Corner of Section 495 Ft West from Southeast Corner of Section

Principal Contractor
 Thompson Drilling Co., Inc. Geologist
JAMES B. REED


Spud Date
 8-14-1987 Total Depth 1000 P.B.T.D.

Date Completed
 8-1987 Oil Purchaser

RECEIVED

S. 35 T 28 R. 16 F W

Loc. SW SE SE
 County WILSON

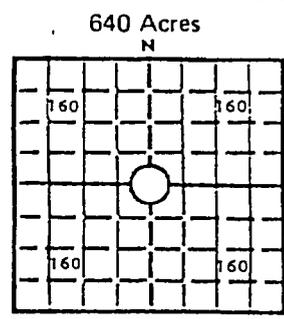

Locate well correctly
 Elev.: Gr. _____
 DF _____ KB _____

CASING RECORD

Report of all strings set—surface, intermediate, production, etc.

Purpose of string	Size hole drilled	Size casing set (in O.D.)	Weight lbs/ft.	Setting depth	Type cement	Sacks	Type and percent additives
SURFACE	10"	6-5/8"		22	Portland	6	None
PRODUCTION	5-1/8"	2-7/8"					

WELL LOG

Show all important zones of porosity and contents thereof; cored intervals, and all drill-stem tests, including depth interval tested, cushion used, time tool open, flowing and shut-in pressures, and recoveries.

Formation	Top	Btm.	Formation	Top	Btm.	Formation	Top	Btm.
Clay	0	9	Sand	478	536	Sandy Shale	951	1000
Lime	9	11	Lime (PINK)	536	559	T.D.	1000	
Shale	11	70	Shale	559	574			
Lime	70	71	Sand	574	597	1-2 1/2 Froot Shoe		
nd	71	98	Lime (OSW)	597	618	4-2 1/2 Centralizers		
Lime	98	101	Shale	618	624	1-2 1/2 Clamp		
Shale	101	127	Lime (OSW)	624	632			
Lime	127	228	Shale	632	634			
Shale	228	242	Lime (OSW)	634	639			
Lime	242	267	Shale	639	651			
Shale	267	272	Sand (OIL)	651	665			
Lime	272	283	Shale	665	703			
Shale	283	300	Sandy Shale	703	709			
Lime	300	329	Sand	709	757			
Shale	329	359	Sand (OIL)	757	759			
Lime	359	361	Shale	759	760			
Sandy Shale	361	385	Sand (OIL)	760	805			
Lime	385	405	Lime	805	807			
Sandy Shale	405	414	Sand	807	846			
Lime	414	429	Shale	846	915			
Shale	429	432	Sand	915	926			
Lime	432	433	Sand (OIL)	926	944			
Sandy Shale	433	478	Shale	944	951			

STATE CORPORATION COMMISSION
 UEC 22 1987
 CONSERVATION DIVISION
 Wichita, Kansas