


Map No. _____ Sec. 10 Twp. 29 R. 4
 Well No. 1 Warner Farm _____
Ohio Company _____

NORTH

WEST

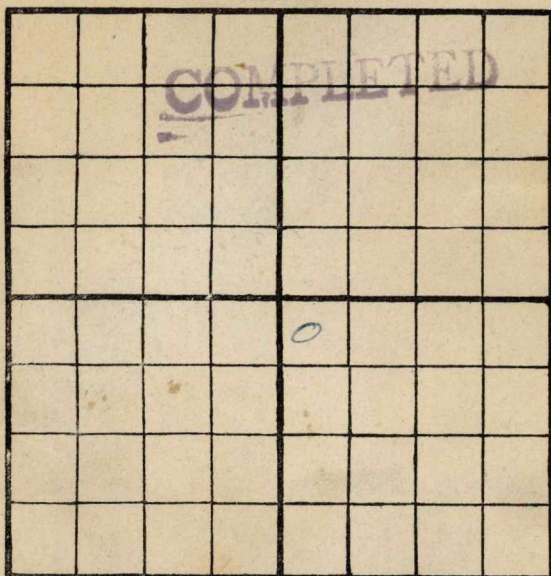

EAST

SOUTH

Location _____

Rig Up _____

Drilling Remarks:

Drilling Remarks:

RECORD

Cased _____ in. _____ ft.

Sand _____

Gas _____

Oil _____

Total Depth _____

PRODUCTION

1st 24 hrs. Nat. _____

1st 24 hrs. after shot _____

Gas _____ cu. ft


Dry Hole _____

Abandoned _____

Map No. _____ Sec. 10 Twp. 29 R. 4Well No. 1 Warner FarmOhio Company

NORTH

WEST

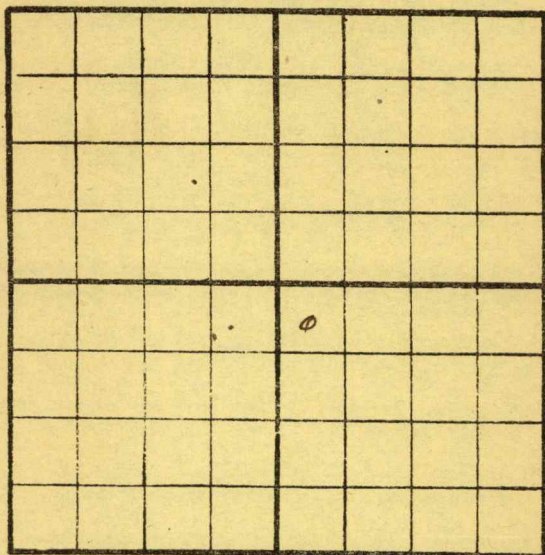

EAST

SOUTH

Location _____

Rig up _____

Drilling and remarks:

RECORD

Cased _____ in. _____ Ft.

Sand _____

Gas _____

Oil _____

Total Depth _____

PRODUCTION

1st. 24 hrs. Nat. _____

1st. 24 hrs. after shot. _____

Gas _____ Cu. Ft.

Dry Hole _____

Abandoned _____


Date

7/24, 1917, C. C. Cady Scout

Map No. _____ Sec. 10 Twp. 29 R. 4
 Well No. Warner Farm _____
Ohio Company _____

NORTH

WEST

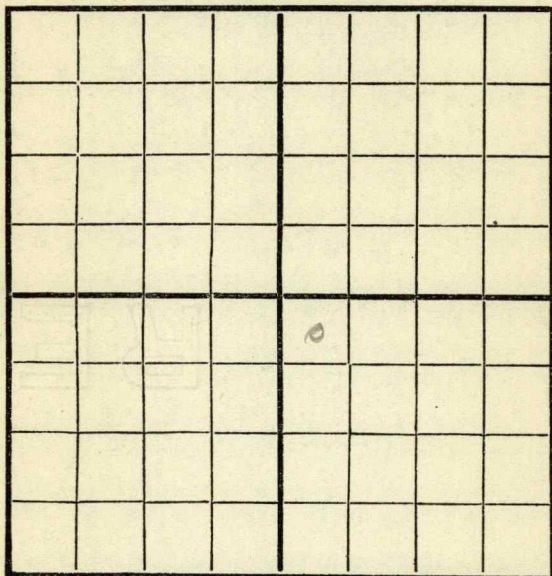

EAST

SOUTH

Location _____
 Rig Up _____
 Drilling and remarks _____

300

RECORD

Cased _____ in. _____ Ft.
 Sand _____
 Gas _____
 Oil _____
 Total Depth _____

PRODUCTION

1st 24 hrs. Nat. _____
 1st 24 hrs. after shot _____
 Gas _____ Cu. Ft.
 Dry Hole _____
 Abandoned _____

Date


8/1, 191 2 Cordery Scout

Map No. _____ Sec. 10 Twp. 29 R. 4Well No. 1 Farm _____

Company _____

NORTH

WEST

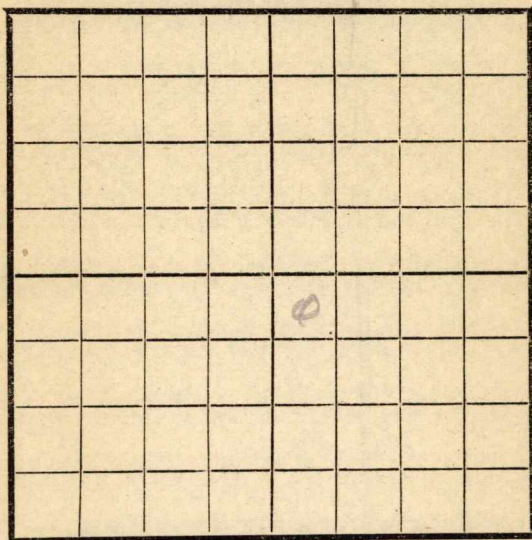

EAST

SOUTH

Location _____

Rig Up _____

Drilling and remarks

RECORD

Cased _____ in _____ Ft.

Sand _____

Gas _____

Oil _____

Total Depth _____

PRODUCTION

1st 24 hrs. Nat. _____

1st 24 hrs. after shot _____

Gas _____ Cu. Ft.

Dry Hole _____

Abandoned _____


Date

8/17, 1917 Scout

Map No. _____ Sec. 10 Twp. 29 R. 4Well No. J. Warner Farm
Ohio Company

NORTH

WEST

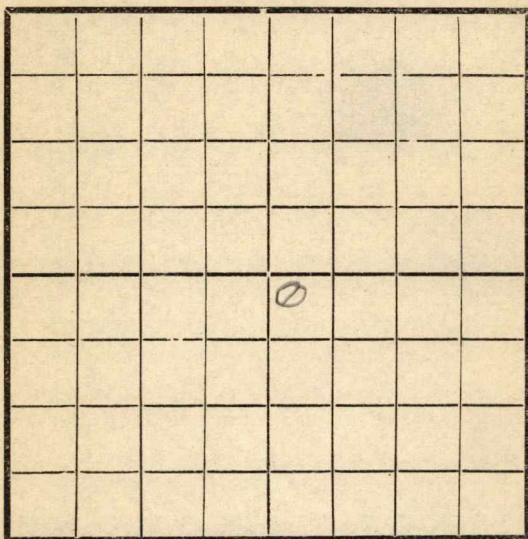

EAST

SOUTH

Location _____

Rig Up _____

Drilling and remarks

at 1800.

RECORD

Cased _____ in. _____ Ft.

Sand _____

Gas _____

Oil _____

Total Depth _____

PRODUCTION

1st 24 hrs. Nat. _____

1st 24 hrs. after shot _____

Gas _____ Cu. Ft.

Dry Hole _____

Abandoned _____

Date


8-30, 1917 Lautz Scout

Map No. _____ Sec. 10 Twp. 29 R. 4
 Well No. 171 Farm _____
Ohio Company _____

NORTH

WEST

EAST

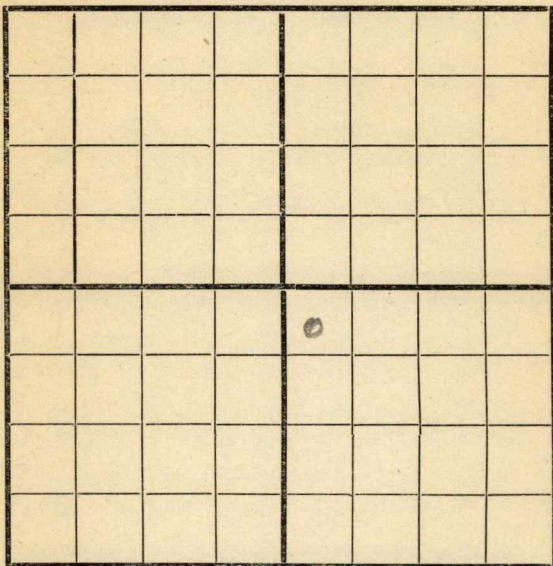

SOUTH

Location _____

Rig Up _____

Drilling and remarks

2580

RECORD

Cased _____ in. _____ Ft.

Sand _____

Gas _____

Oil _____

Total Depth _____

PRODUCTION

1st 24 hrs. Nat. _____

1st 24 hrs. after shot _____

Gas _____ Cu. Ft.

Dry Hole _____


Abandoned _____

Date

9/5, 1917 Corday Scout

Map No. _____ Sec. 10 Twp. 29 R. 4
 Well No. 1 Warner _____ Farm
Ohio _____ Company

NORTH

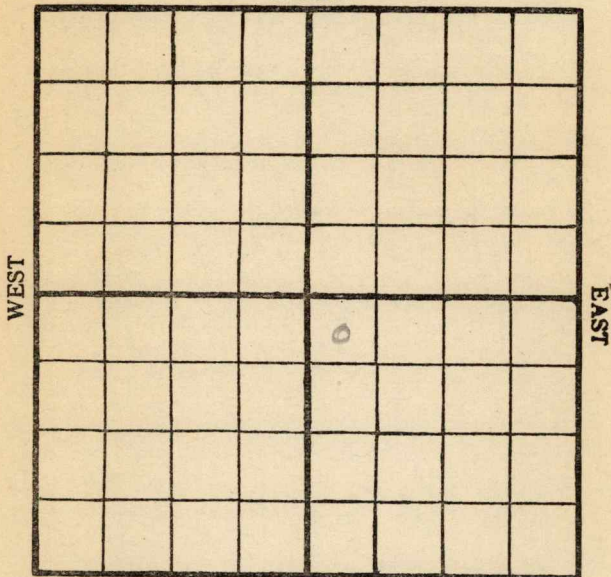

SOUTH

Location _____

Rig Up _____

Drilling and remarks

5800'

RECORD

Cased _____ in. _____ Ft.

Sand _____

Gas _____

Oil _____

Total Depth _____

PRODUCTION

1st 24 hrs. Nat. _____

1st 24 hrs. after shot _____

Gas _____ Cu. Ft.

Dry Hole _____

Abandoned _____

Date


9/12, 1917 Cardiff Scout

Map No. _____ Sec. 10 Twp. 9 R. 4
 Well No. 1 Warner Farm _____
Ohio Company _____

NORTH

WEST

EAST

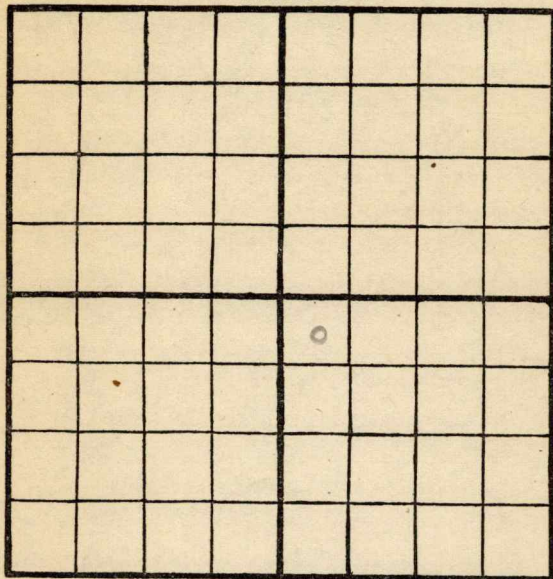

SOUTH

Location _____

Rig Up _____

Drilling and remarks

3100'

RECORD

Cased _____ in. _____ Ft.

Sand _____

Gas _____

Oil _____

Total Depth _____

PRODUCTION

1st 24 hrs. Nat. _____

1st 24 hrs. after shot _____

Gas _____ Cu. Ft.

Dry Hole _____

Abandoned _____

Date

9/19, 1917 Cardeff Scout

Butler
 K11 **KANSAS** SEC. *10* TWP. *29S* R. *4E*
 MAP NO. _____

WELL NO. *1 Warner*
Med - Kans COMPANY _____

CONTRACTOR _____

SECTION PLAT

ABANDONED

_____ FT. FROM N. LINE

_____ FT. FROM S. LINE

_____ FT. FROM E. LINE

_____ FT. FROM W. LINE

		0	

LOCATION _____

RIG UP _____

DRILLING AND REMARKS:

RECORD

CASED _____ IN. _____ FT.

SAND _____

GAS _____

OIL _____

TOTAL DEPTH *3120*

PRODUCTION

1ST 24 HRS. NAT. _____

1ST 24 HRS. AFTER SHOT _____

GAS _____ CU. FT.

DRY HOLE ☒

ABANDONED ☒

DATE

9-24 19*17* _____ SCOUT

Map No. _____ Sec. 10 Twp. 29 R. 4
Well No. 1 Warner Farm _____
Ohio Company _____

NORTH

WEST



EAST

SOUTH

RECORD

Location _____
Rig Up _____
Drilling and remarks

Cased _____ in. _____ Ft.
Sand _____
Gas _____
Oil _____
Total Depth _____

PRODUCTION

1st 24 hrs. Nat. _____
1st 24 hrs. after shot _____
Gas _____ Cu. Ft.
Dry Hole _____
Abandoned _____

Date 9/27 1917 C. C. Coffey Scout