


KANSAS

Ellsworth

Section 32 Township 17 Range 10-W

Well No. #3 Disque

Company Transwestern et al

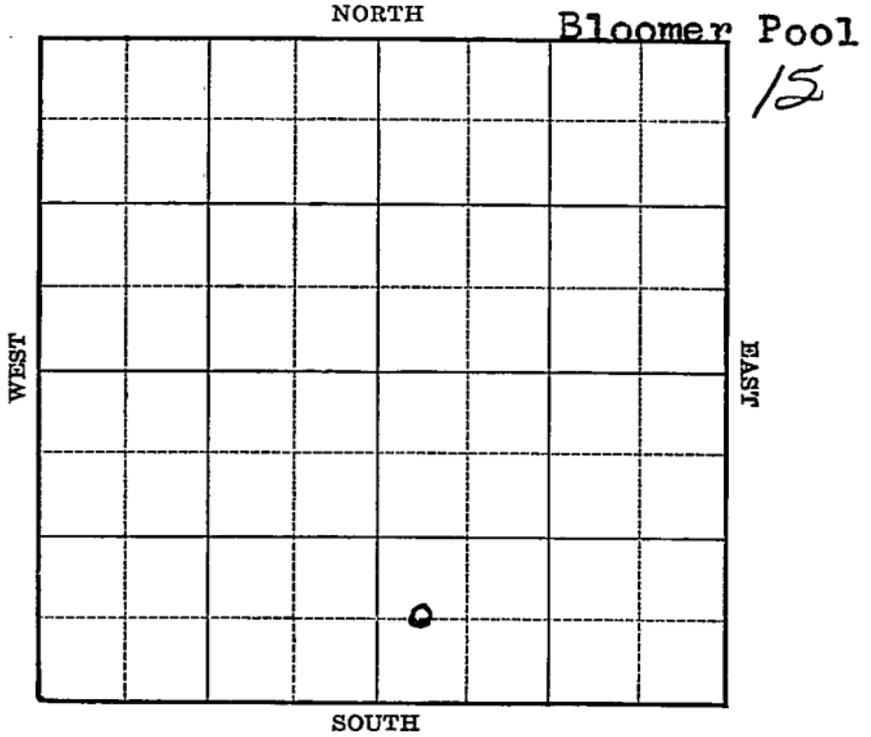

Sec. 32 Twp. 17 R. 10-W

Well No. #3 Disque Farm

Transwestern et al Company


(Bloomer)

_____ Ft. from N. Line

660 Ft. from S. Line

_____ Ft. from E. Line

330 Ft. from W. Line

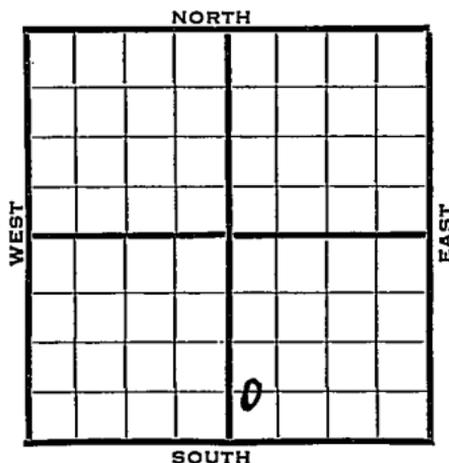

Elev. 1783

1940	REPORT
6/5	Location
6/13	10" - 217' WOC.
6/20	Drlg. 2639'
6/27	Cong. 3218' Arb. 3241' 3243
	5" - 3242' T.D. RUST.
7/3	Arb. 3243' (Corrected)
	At 3260' 8 bbls. per hour.
	1000 acid. Pump 16 bbls. per hr
	Drlg. 3268'
7/10	Arb. 3243'
	5" - 3244'
	T.D. 3268'
	4000 acid.
	Echometer potential 1309 bbls.
	COMPLETED

Map No. 55 Sec. 32 Twp. 17 R. 10WWell No. 3 DisqueTranswestern et al Company

Contractor

FIRST REPORT
C W L SW SE

SECTION PLAT

 Ft. from N. Line660 Ft. from S. Line Ft. from E. Line330 Ft. from W. Line

		o	

BLOOMER POOL

Location XRig up

Drilling and Remarks:

RECORD

Cased in., ft.Sand Gas Oil Total Depth

PRODUCTION

1st 24 hrs. Nat. 1st 24 hrs. after shot Gas Cu. Ft.Dry Hole Abandoned

Date

JUN 5 1940 19 S. J. LEWIS Scout

Map No. _____ Sec. 32 Twp. 17 R. 10WWell No. 3 Disque

_____ Transwestern etal _____ Company

_____ Contractor

COMPLETED**SECTION PLAT**

		0	

C W L SW SE

_____ Ft. from N. Line

660 Ft. from S. Line

_____ Ft. from E. Line

330 Ft. from W. Line

BLOOMER POOL

Location _____

Rig up _____

Drilling and Remarks:

*Well 3248**5" @ 3244**4000 acid**Eckomets 128**1309***RECORD**

Cased _____ in., _____ ft.

Sand _____

Gas _____

Oil _____

Total Depth 3268**PRODUCTION**

1st 24 hrs. Nat. _____

1st 24 hrs. after shot _____

Gas _____ Cu. Ft.

Dry Hole _____

Abandoned _____

Date

III 10 1940 19S. J. LEWIS Scout