


Section 13 Township 29 Range 4E

Well No. #2 Cleasly

Company Marhenke Drlg.

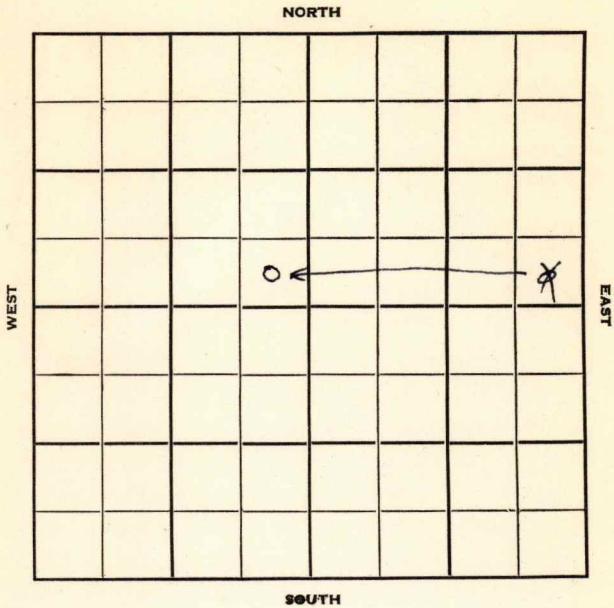



Sec. 13 Twp. 29 R. 4E

Well No. #2 Cleasly Farm

Marhenke Drlg. Company

Contractor


 Ft. from N. Line

330' Ft. from S. Line

330' Ft. from E. Line

 Ft. from W. Line

SE SE ~~NE~~
NW

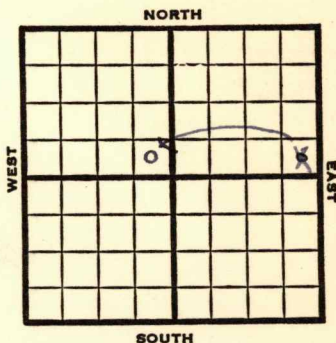

1950 **Elev. 1293'** REPORT

12/20 Location

1951

2/21

Spud 1-17-51

D&A TD 2970

10" @ 907 8" @ 2035

Lans. 1945' **KC 2280**

Miss 2914 7" @ 2890

TD 2970 D&A

ABANDONED

Kansas

Map No. _____ Sec. 13 Twp. 29 R. 4EWell No. 2 Cleasley

Marhenke Drlg. _____ Company

CORRECTION

Contractor

SE SE NW

SECTION PLAT

_____ Ft. from N. Line

330 Ft. from S. Line330 Ft. from E. Line

_____ Ft. from W. Line

Butler County

Location _____

Rig up _____

Drilling and Remarks:

Reported

SE SE NE

RECORD

Cased _____ in., _____ ft.

Sand _____

Gas _____

Oil _____

Total Depth _____

PRODUCTION

1st 24 hrs. Nat. _____

1st 24 hrs. after shot _____

Gas _____ Cu. Ft.

Dry Hole _____

Abandoned _____

Date

DEC 27 1950 19

J. E. TYRA Scout

County Butler State KansasSec. 13 (Blk.
Twp.) 29 (Sur.
Rge.) 4 E Map No.Operator Marhenke Drlg.Well No. 2 Farm CleaslyElev. 1293 Location SE SE NW330 Ft. From S Line NW330 Ft. From E Line Quarter

1st. Report _____

Completion FFB 21 1951

Remarks _____

Spudding Date 1-17-51Drlg. Data D & A TD 297010" @ 907 8" @ 2035 Lans. 1945KC 2280 Miss. 2914 7" @ 2890 TD 2970D & A

J. E. TYRA