


Butler

KANSAS

Section 13 Township 29 Range 4E

Well No. #4 Cleasley-Probert

Company Marhenke Drlg.

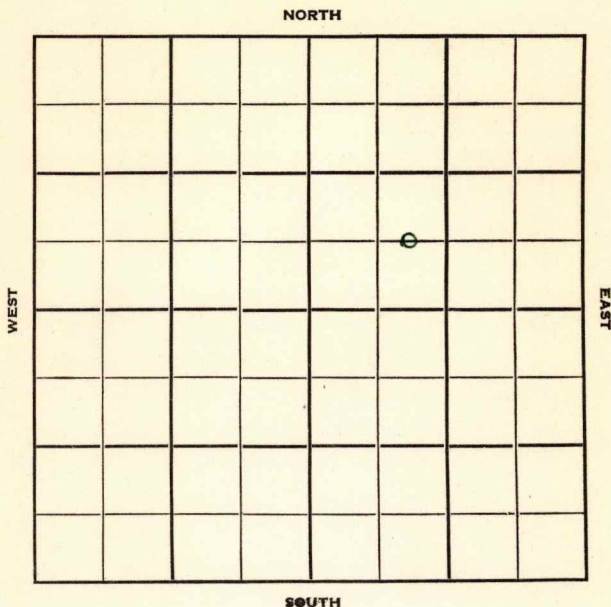

Butler

KANSAS

Sec. 13 Twp. 29 R. 4E ✓

Well No. #4 Cleasley-Probert Farm

Marhenke Drlg.

Company

Contractor

Duglas

Ft. from N. Line

660


Ft. from S. Line

Ft. from E. Line

990

Ft. from W. Line

C E/2 SW NE

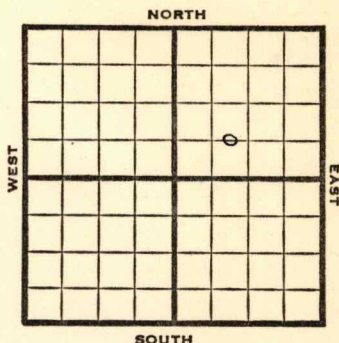

SOUTH

1951

Elev. 1270'

REPORT

11/28

Drlg. 215'

13" @ 102'

1952

1/23

Spud 11-24-51

Oil well TD 2828

13" @ 102' 10" @ 875' 8" @ 1665


Lans. 1925 7" @ 2450

Bart. 2795 5" @ 2796 TD 2828

60 qt./ 2805-23

Comp. 25 BOPD

COMPLETED

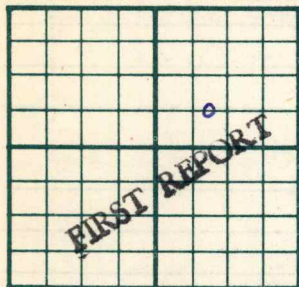
County **Butler** State **Kansas**Sec. **13** (Blk.) **29** (Sur.) **4E** Map No.Operator **Marhenke Drlg.**Well No. **4** Farm **Cleasley-Probert**Elev. Location **C E/2 SW NE****660** Ft. From **S** Line **NE****990** Ft. From **W** Line **Quarter**1st. Report **NOV 28 1951**

Completion

Remarks

Spudding Date **11-24-51**Drlg. Data **Duglas****13" @ 102 Drlg. 215****J. E. TYRA**

County Butler State Kansas
 Sec. 13 (Blk. 29) (Sur. 4E) Map No. _____
 Operator Marhenke Drlg.
 Well No. 4 Farm Cleasley-Probert
 Elev. 1270 Location C E L SW NE

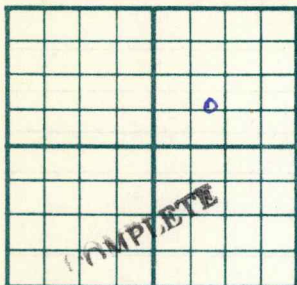

660 Ft. From S Line NE
990 Ft. From W Line Quarter
 1st. Report _____
 Completion JAN 23 1952
 Remarks Douglas Pool

Spudding Date 11-24-51

Drlg. Data Oil well TD 2828
13" @ 102 10" @ 875 8" @ 1665
Lans. 1925 7" @ 2450 Bart. 2795
5" @ 2796 TD 2828 60 qt/ 2805-23
Comp. 25 bopd

J. G. McGEHEE