

KANSAS

Ellsworth


Form 51-5M-7-39-Palace

Section 32 Township 17 Range 10-W

Well No. #3 Link

Company Magnolia

NORTH Bloomer Pool //

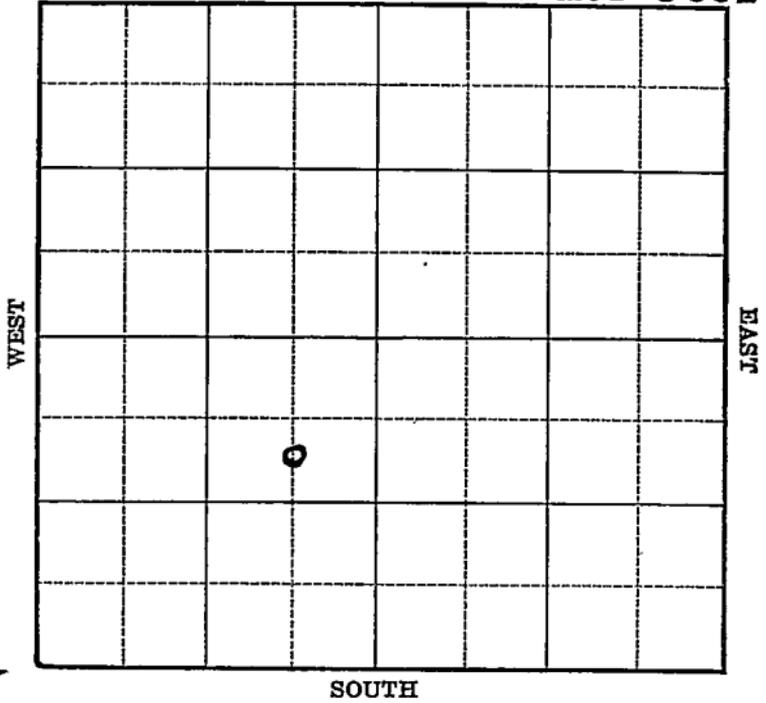

Map No. 55 Sec. 32 Twp. 17 R. 10W

Well No. 3 Zink

Magnolia Company

Contractor

FIRST REPORT

SECTION PLAT

C S L NE SW

990 Ft. from N. Line

_____ Ft. from S. Line

660 Ft. from E. Line

_____ Ft. from W. Line

BLOOMER POOL

Location _____

Rig up _____

Drilling and Remarks:

10" - 208

WOC

RECORD

Cased _____ in., _____ ft.

Sand _____

Gas _____

Oil _____

Total Depth _____

PRODUCTION

1st 24 hrs. Nat. _____

1st 24 hrs. after shot _____

Gas _____ Cu. Ft.

Dry Hole _____

Abandoned _____

Date

JUN 5 1940 19

S. J. LEWIS

Scout

Map No. 55 Sec. 32 Twp. 17 R. 10W

Well No. 3 Zink

Magnolia Company

Contractor

COMPLETED

C S L N E SW

990 Ft. from N. Line

_____ Ft. from S. Line

660 Ft. from E. Line

_____ Ft. from W. Line

BLOOMER POOL.

SECTION PLAT

Location _____

Rig up _____

Drilling and Remarks:

*Per # 3214 Corrected
5" @ 3216.
1000 add'l
Eckometer P.S.
1678*

RECORD

Cased _____ in., _____ ft.

Sand _____

Gas _____

Oil _____

Total Depth 3222

PRODUCTION

1st 24 hrs. Nat. _____

1st 24 hrs. after shot _____

Gas _____ Cu. Ft.

Dry Hole _____

Abandoned _____

Date

JUL 2 1940 19

S. J. LEWIS Scout