


Section 32 Township 17 Range 10-W

Well No. #3 Zink

Company Skelly

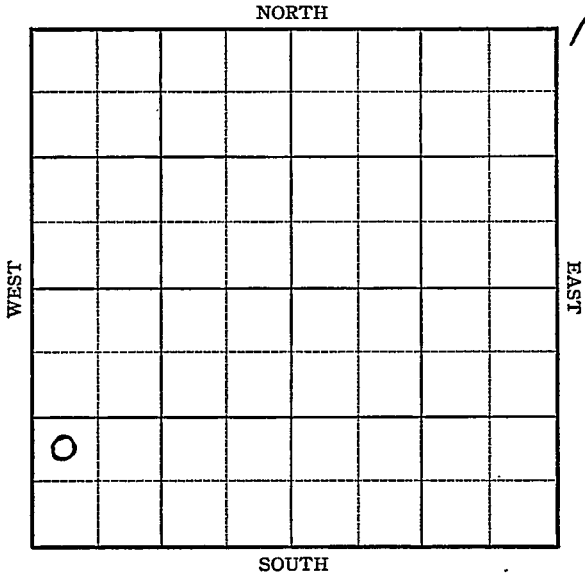

Sec. 32 Twp. 17 R. 10-7

Well No. #3 Zink Farm

Skelly Company


_____ Ft. from N. Line

990 Ft. from S. Line

_____ Ft. from E. Line

330 Ft. from W. Line

Elev. 1786

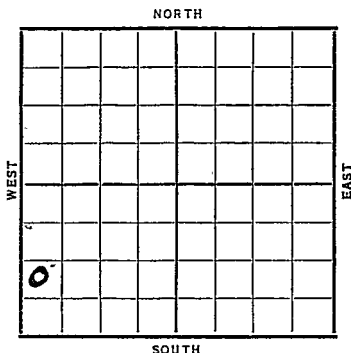

Date	REPORT
1937	
11/17	Location
11/26	B. R. R.
12/3	13" @ 200'. WOC.
12/10	Drlg. 3025'.
12/17	" "
12/24	L.C. 2939'. Sat. 3301-3306'.
	7" @ 3005'. Coring 3014'.
12/31	T.D. 3020'. Flowed 515 oil 17
	hrs. 1½ M gas Nat.
	5000 acid. 6,075,000 gas.
	Flowed 325 oil 1st 30 min on
	potential.
	OVER

1938

1/5

7" @ 3003'.

K. C. 2939'.

T.D. 3020'.

5000 acid.

Flowed 1229.6 bbls. 4 hrs &
1221 bbls. 4 hrs.

Potential 7327 oil.

7 M gas.

COMPLETED

Map No. _____ Sec. 32 Twp. 17 R. 10WWell No. 3 Zink_____ Skelly _____ Company

_____ Contractor

FIRST REPORT

SECTION PLAT

NW SW SW

_____ Ft. from N. Line

990 Ft. from S. Line

_____ Ft. from E. Line

330 Ft. from W. Line .

0			

Location X

Rig up _____

Drilling and Remarks:

RECORD

Cased _____ in., _____ ft.

Sand _____

Gas _____

Oil _____

Total Depth _____

PRODUCTION

1st 24 hrs. Nat. _____

1st 24 hrs. after shot _____

Gas _____ Cu. Ft.

Dry Hole _____

Abandoned _____

Date

NOV 17 1937 19 _____ H. D. Hatfield Scout

