


KANSAS Ellsworth

FORM 51 5M PETROL

Section 32 Township 17 Range 10W

Well No. 4 Smith

Company Skelly

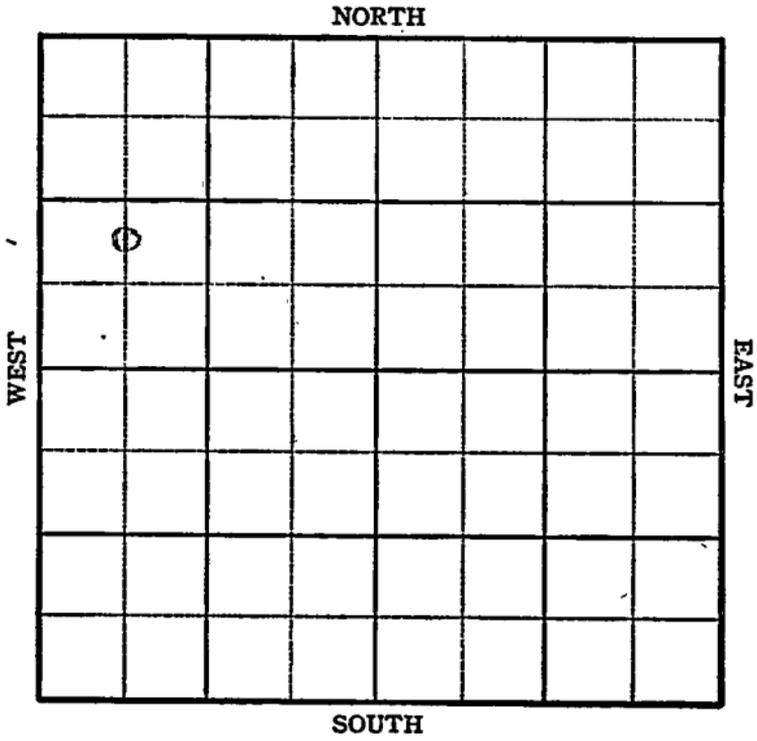

Sec. 32 Twp. 17 R. 10-W

Well No. #4 Smith Farm


Skelly Company

_____ Ft. from N. Line

990 Ft. from S. Line

_____ Ft. from E. Line

660 Ft. from W. Line

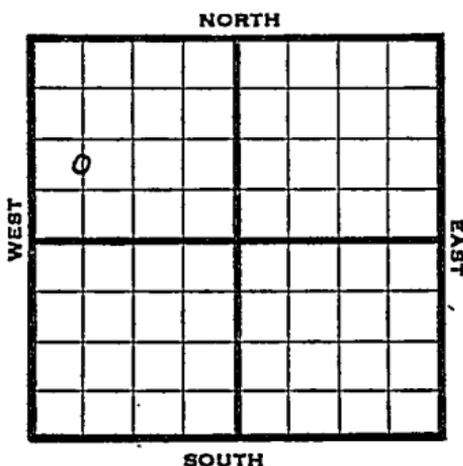

C N L SW NW

1945 Elev. 1795

REPORT

10/17 Location

10/24 RUR

10/31 8" @ 220

Drilg. 1753

11/7 Lāns 2960

Arb. 3254

TD 3255 Run csg.

11/14 5" @ 3255 RUST

11/21 TD 3268

2500' oil in 2 hrs.

11/28 Arb. 3254

5" 3255

TD 3268'

Echo Pot. 1608

Grav. 42.6

COMPLETED

