


Section 32 Township 17 Range 10-W

Well No. #4 Disque

Company Transwestern et al

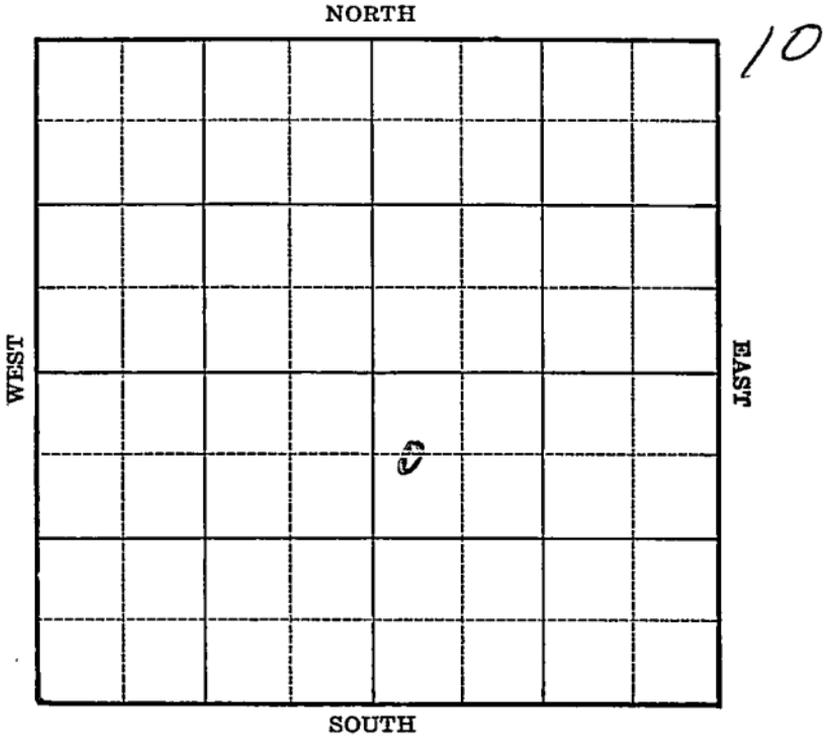

Sec. 32 Twp. 17 R. 10-W

Well No. #4 Disque Farm _____

Transwestern et al Company

(Bloomer)


660 Ft. from N. Line

_____ Ft. from S. Line

_____ Ft. from E. Line

330 Ft. from W. Line

Elev. 1786

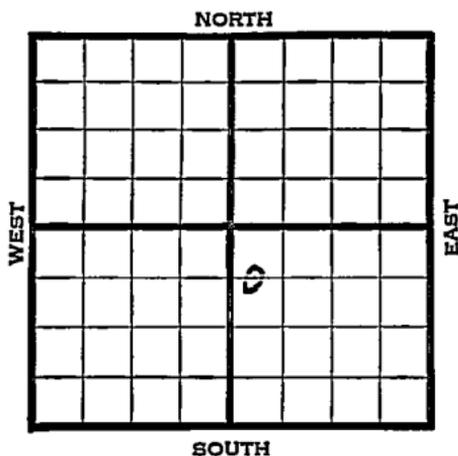

1940	REPORT
9/11	10" - 207' WOC.
9/19	Drlg. 2511'
9/26	Lansing 2929' Cong. 3231'
	Arb. 3243-51' T.D. 5" - 3246'
	RUST.
10/3	3272' T.D. 2500' oil 1½ hrs.
	3000 acid.
10/9	Arb. 3243'
	5" - 3246'
	T.D. 3272'
	3000 acid.
	Depthograph potential 2616 bbls.
	COMPLETED

Map No. 55 Sec. 32 Twp. 17 R. 10W

Well No. 4 Disque

Transwestern etal Company

Contractor

FIRST REPORT

SECTION PLAT

C W L NW SE

660 Ft. from N. Line

_____ Ft. from S. Line

_____ Ft. from E. Line

330 Ft. from W. Line

		0	

BLOOMER POOL

Location _____

Rig up _____

Drilling and Remarks:

10" - 207

WOC

RECORD

Cased _____ in., _____ ft.

Sand _____

Gas _____

Oil _____

Total Depth _____

PRODUCTION

1st 24 hrs. Nat. _____

1st 24 hrs. after shot _____

Gas _____ Cu. Ft.

Dry Hole _____

Abandoned _____

Date

SEP 11 1940 19

S. J. LEWIS Scout

Map No. 55 Sec. 32 Twp. 17 R. 10WWell No. 4 DisqueTranswestern etal Company

Contractor

COMPLETED

C W L NW SE

660 Ft. from N. Line Ft. from S. Line Ft. from E. Line330 Ft. from W. Line

BLOOMER POOL

SECTION PLAT

		o	

Location _____

Rig up _____

Drilling and Remarks:

*Cu # 3243**5" C 3246**3000 acid**Depth. 2616 P.X.***RECORD**

Cased _____ in., _____ ft.

Sand _____

Gas _____

Oil _____

Total Depth 2272**PRODUCTION**

1st 24 hrs. Nat. _____

1st 24 hrs. after shot _____

Gas _____ Cu. Ft.

Dry Hole _____

Abandoned _____

Date

OCT 9 1940 19S. J. LEWIS Scout