

Section 13 Township 29 Range 4E

Well No. #3 Elliott

Company E. B. Shawver

NORTH

|  |  |  |  |  |  |  |   |
|--|--|--|--|--|--|--|---|
|  |  |  |  |  |  |  |   |
|  |  |  |  |  |  |  | C |
|  |  |  |  |  |  |  |   |
|  |  |  |  |  |  |  |   |
WEST

EAST

SOUTH

Butler

KANSAS

Sec. 13 Twp. 29 R. 4E

Well No. #3 Elliott Farm

E. B. Shawver Company

Shawver Contractor


990 Ft. from N. Line

Ft. from S. Line

330 Ft. from E. Line

Ft. from W. Line

SE NE NE

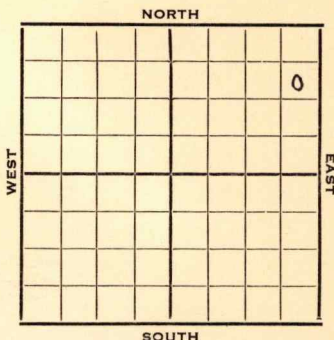

1952

Elev. 1299' REPORT

8/20 MI

9/17 Spud 8-20-52  
Oil well TD 2833'  
10" @ 58 Bart 2808' 5" @ 2808  
TD 2833' PB 2831  
Comp. 25 BOPD

COMPLETED



County **Butler** State **Kansas**

Sec. **13** (Blk. Twp.) **29** (Sur. Rge.) **4E** Map No.

Operator E. B. Shawver

Well No. 3 Farm Elliott

| Elev. | Location | SE NE NE |
|-------|----------|----------|
|       |          |          |

**FIRST REPORT**

990 Ft. From N Line NE

| 330 | Ft. From E | Line | Quarter |
|-----|------------|------|---------|
|-----|------------|------|---------|

1st. Report AUG 20 1952

### Completion

Remarks

Shawver - Contr.

Spudding Date \_\_\_\_\_

Drlg. Data

III

**J. G. McGEHEE**