


Section 13 Township 29 Range 4E

Well No. #2 Hodges

Company Marhenke Drlg.

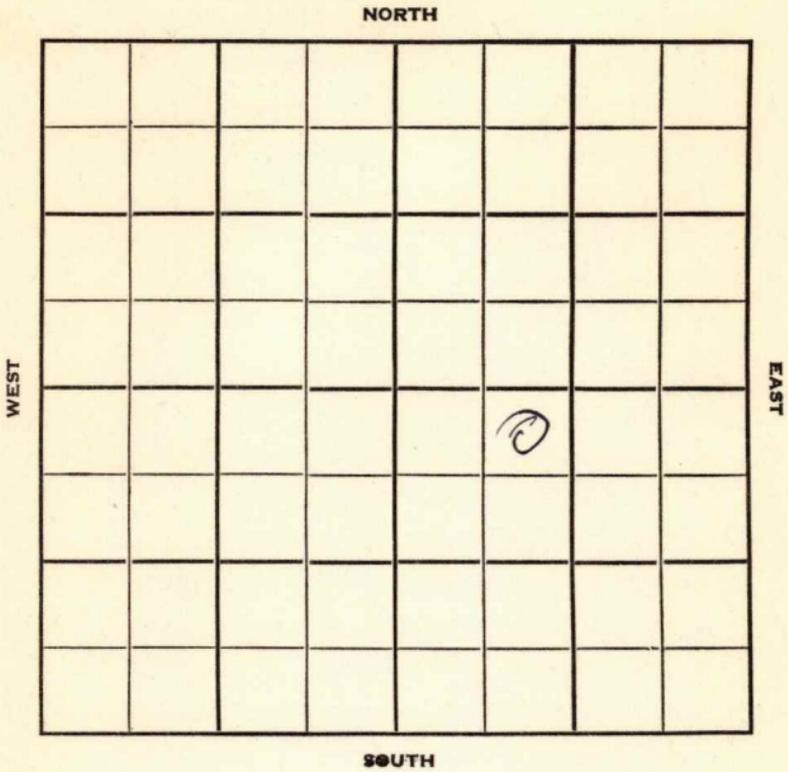

Butler

KANSAS

Sec. 13 Twp. 29 R. 4 E

Well No. # 2 Hodges Farm

Marhenke Drlg. Company

Marhenke Contractor

**Muddy Creek Pool**


330 Ft. from N. Line

\_\_\_\_\_ Ft. from S. Line

\_\_\_\_\_ Ft. from E. Line

990 Ft. from W. Line

NE NW SE

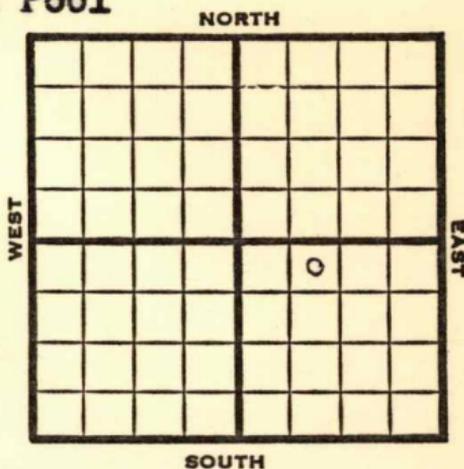

1951

Elev. 1280'

REPORT

6/6

Spud 6-2-51  
Drlg. 425'

7/11

Spud 6-2-51	Oil well	TD 2829'
10" @ 880'	Lans 1930'	8" @ 2130
Bart 2815'	TD 2829'	5" @ 2816'
Hydrofrac	PB 2824'	9 BOPH
Hydrofrac	S/30 BOPD	
Comp. 25 BOPD		

**COMPLETED**



County Butler State Kansas

Sec. 13 (Blk. 29 (Sur. 4E (Twp. Rge.) Map No.

Operator Marhenke Drlg.

Well No. 2 Farm Hodges

Elev. 1280 Location NE NW SE


**COMPLETE**

330 Ft. From N Line SE

990 Ft. From W Line Quarter

1st. Report

Completion JUL 11 1951

Remarks Muddy Creek Pool

Marhenke - Contr.

Spudding Date 6-2-51

Drlg. Data Oil well TD 2829

10" @ 880 Lans. 1930 8" @ 2130

Bart. 2815 TD 2829 5" @ 2816

Hydrofrac PB 2824 9 boph

Hydrofrac S/ 30 bopd

Comp. 25 bopd