

KANSAS


Ellsworth

Form 51-5M-7-40-Palate

Section 32 Township 17 Range 10-W

Well No. #4 Zink

Company Magnolia

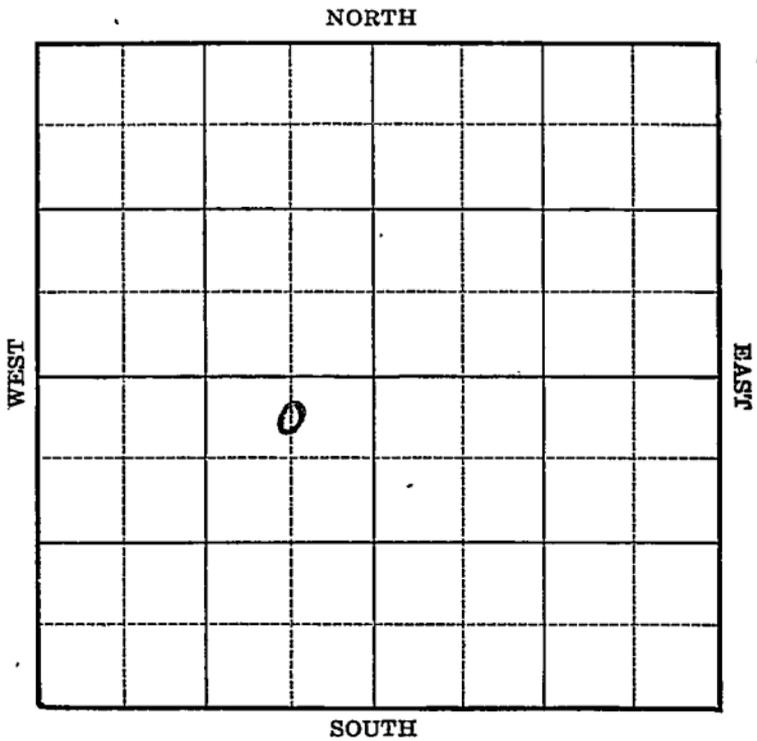

Sec. 32 Twp. 17 R. 10-W

Well No. #4 Zink Farm
Magnolia Company

(Blommer)


330 Ft. from N. Line

_____ Ft. from S. Line

660 Ft. from E. Line

_____ Ft. from W. Line

Elev. 1780

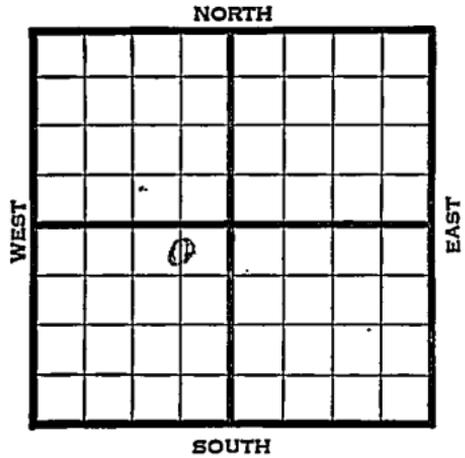

1940	REPORT
12/30	Derrick 1
1941	
1/9	10" - 256' Drlg. 720'
1/16	Drlg. 2672'
1/23	Lans. 2940' Arb. 3224-30' T.D. 5" - 3226' RUST. SAT.
1/30	T.D. 3242' 3000 acid. 1/2 bbl. oil per hour. Will drill deeper.
2/5	Arb. 3224' 5" - 3226' T.D. 3242' 3000 acid. Pump 505 oil & S.W., potential. 42.6 Gravity
	COMPLETED

Map No. 53 Sec. 32 Twp. 17 R. 10W

Well No. 4 Zink

Magnolia Company

Contractor

FIRST REPORT

C N L NE SW

SECTION PLAT

330 Ft. from N. Line

	o		

_____ Ft. from S. Line

660 Ft. from E. Line

_____ Ft. from W. Line

BLOOMER POOL

Location _____

RECORD

Rig up _____

Cased _____ in., _____ ft.

Drilling and Remarks:

Sand _____

Derrick

Gas _____

Oil _____

Total Depth _____

PRODUCTION

1st 24 hrs. Nat. _____

1st 24 hrs. after shot _____

Gas _____ Cu. Ft.

Dry Hole _____

Abandoned _____

Date

DEC 30 1940 19

S. J. LEWIS

Scout

Map No. 55 Sec. 32 Twp. 17 R. 10WWell No. 4 ZinkMagnolia Company

Contractor

~~COMPLETED~~

SECTION PLAT

C N L NE SW

330 Ft. from N. Line

_____ Ft. from S. Line

660 Ft. from E. Line

_____ Ft. from W. Line

	o		

BLOOMER POOL

Location _____

Rig up _____

Drilling and Remarks:

*Cr 83224**5" @ 3226**3000 acid**Pump 500 oil SW.**P. J.**42.6 Gr.*

RECORD

Cased _____ in., _____ ft.

Sand _____

Gas _____

Oil _____

Total Depth 3242

PRODUCTION

1st 24 hrs. Nat. _____

1st 24 hrs. after shot _____

Gas _____ Cu. Ft.

Dry Hole _____

Abandoned _____

Date

FEB 5 1941 19S. J. LEWIS Scout