


Butler

KANSAS

SECTION 16 TOWNSHIP 29S RANGE 4E

WELL NO. #3 Asmusson

COMPANY A.D. Allison

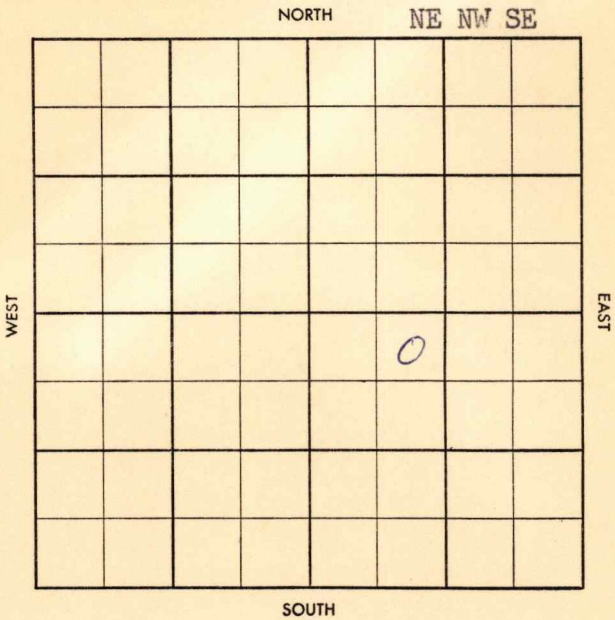

29

County Butler Elev. _____
 Sec. 16 Twp. 29 Rge. 4E
 Company A. D. Allison
 Farm Name Asmusson No. 3

TOPS	DEPTH	LOG	DATUM
Anh.			
Tp.			
H.			
Tr.			
Dg.			
B.L.			
L.			
K.C.			
B.K.C.			
Ce.			
C.			
M.			
M.			
K.			
Mz.			
Mq.			
V.			
S.			
S.			
A.			
R.			
Pf.			
G.			
T.D.			

Loc. in Sec. _____
NE NW SE
 Geol. _____
 Contr. G. D. Smitherman
 Pool _____
Asmusson



Date Comm. 2/1/58
8" @ 203 w/175, Drlg. 307.

Co.
No.
Sec.
T.
R.

County Butler Elev. 1225KB 12340
 Sec. 16 Twp. 29 Rge. 4E
 Company A. D. Allison
 Farm Name Asmusson No. 3

TOPS	DEPTH	LOG	DATUM
Anh.			
Tp.			
H.			
Tr.			
Dg.			
B.L.			
L.	<u>1835</u>		
K.C. Base & L.S.	<u>2012</u>		
B.K.C. K.C.	<u>2162</u>		
Ce. B.K.C.	<u>2381</u>		
C.			
M.Li	<u>2708-43</u>		
M.			
Ksh	<u>2783-58</u>		
M.Li	<u>2758-75</u>		
Ksh	<u>2775-2808</u>		
V.			
S.			
S.			
A.	<u>2878-82</u>		
R.			
Pf.			
G.			
T.D.	<u>2882</u>		

Loc. in Sec. NE NW SE

Geol. _____
 Contr. G. D. Smitherman

Pool Asmusson

COMPLETE

FEB 19 '58

Date Comm. 2/1/58
8" @ 203 w/175, Drlg. 307. FEB 12 '58 DST

2778-82 50" g/34" F10 oil 43"

7 BOPH FD 60 -1055 BHP 1100hp"

109 5 1/2" 2879 wuct FEB 13 '58 CO

2882 F10 35 BOPH net thru CSG

25 BOPH NW

Co.
 Sec.
 No.
 Sec.
 T.
 R.