

Woodson


Form 51-5M-2-29-34703

Map No. KANSAS Sec. 21 Twp. 24 R. 14

Well No. 1-Elipot Farm

Mendenhall et al. Company

NORTH

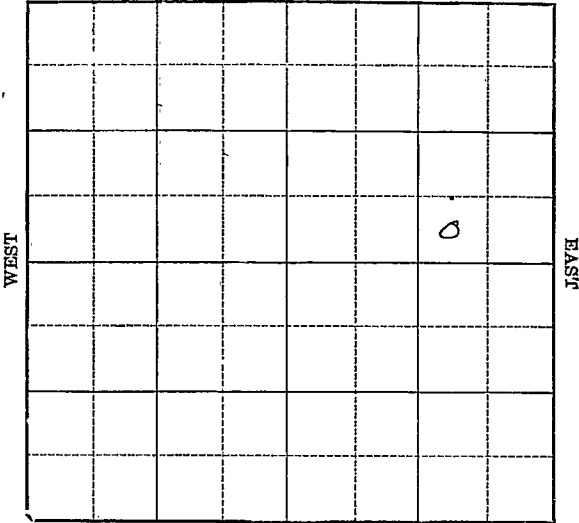

SOUTH

Location _____

Drilling Remarks _____

RECORD

Cased _____ in. _____ ft.

Sand _____

Gas _____

Oil _____

Total Depth _____

Rig Up _____

Drilling Remarks _____

1st 24 hrs. Nat. _____

1st 24 hrs. after shot _____

Gas _____ cu. ft. _____

Dry Hole _____

Abandoned _____

Woodson

MAP NO. *Ans 1* SEC. *21* TWP. *74* R. *114*

WELL NO. *1 Elliott*
Mendenhall et al COMPANY

CONTRACTOR

**FIRST REPORTS
 ABANDONED**

SECTION PLAT

_____ FT. FROM N. LINE
 _____ FT. FROM S. LINE
 _____ FT. FROM E. LINE
 _____ FT. FROM W. LINE

			0

LOCATION _____

RIG UP _____

DRILLING AND REMARKS:

RECORD

CASED _____ IN. _____ FT.
 SAND _____
 GAS _____
 OIL _____
 TOTAL DEPTH *1740*

PRODUCTION

1ST 24 HRS. NAT. _____
 1ST 24 HRS. AFTER SHOT _____
 GAS _____ CU. FT.
 DRY HOLE
 ABANDONED

DATE

5/10/20

192

Shenwood

SCOUT