

10-16-19W


FORM CP-4

STATE OF KANSAS  
STATE CORPORATION COMMISSION  
CONSERVATION DIVISION  
P. O. BOX 17027  
WICHITA, KANSAS 67217

### WELL PLUGGING RECORD

Rush County, Sec 10 Twp 16S Rge 17W (EK) (W)

Location as "NE/CNWESW" or footage from lines SE NW SE  
 Lease Owner Frontier Oil Co.  
 Lease Name Urban "K" Well No 4  
 Office Address 1720 KSB&T Bldg, Wichita, Ks 67202  
 Character of Well (completed as Oil, Gas or Dry Hole) P&A  
 Date well completed February 24, 1976 19  
 Application for plugging filed February 23, 1976 19  
 Application for plugging approved February 23, 1976 19  
 Plugging commenced February 24, 1976 19  
 Plugging completed February 24, 1976 19  
 Reason for abandonment of well or producing formation P&A

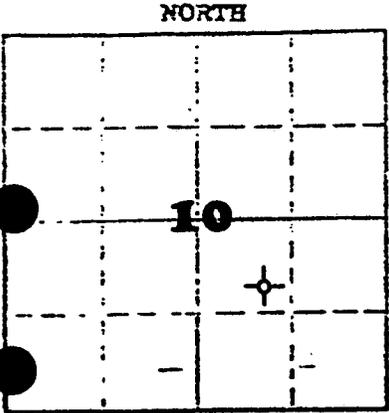

Locate well correctly on above Section Map

If a producing well is abandoned, date of last production 19  
 Was permission obtained from the Conservation Division or its agents before plugging was commenced? yes

Name of Conservator Agent who supervised plugging of this well Leo Massey  
 Plugging from          Depth to top          Bottom          Total Depth of Well 3605 Feet  
 Name depth and thickness of all water, oil and gas formations.

#### OIL, GAS OR WATER RECORDS

#### CASING RECORD

FORMATION	CONTENT	FROM	TO	SIZE	PUT IN	PULLED OUT
				8 5/8"	227.78'	-0-
				4 1/2"	3505.23'	1353.73'

Describe in detail the manner in which the well was plugged, indicating where the mud fluid was placed and the method or methods used in introducing it into the hole. If cement or other plugs were used, state the character of same and depth placed, from          feet to          feet for each plug set.

Pump 200 sx cmt down 8 5/8" w/plug  
 cmt rathole



Name of Plugging Contractor Red Tiger Drilling Co.  
 Address 1720 KSB&T Bldg., Wichita, Ks. 67202

(If additional description is necessary, use BACK of this sheet)

STATE OF Kansas COUNTY OF Sedgwick ss.  
Jean Stocks (employee of owner) or (Not Publicly Licensed) of the above-described

well, being first duly sworn on oath, says: That I have knowledge of the facts, statements, and matters herein contained and the log of the above-described well as filed and that the same are true and correct. So help me God.