


Woodson

Form 51-5M-11-31-Palace

Map No. KANSAS Sec. 28 Twp. 24 R. 14E

Well No. 1 Street Farm  
Sheedy et al Company

NORTH

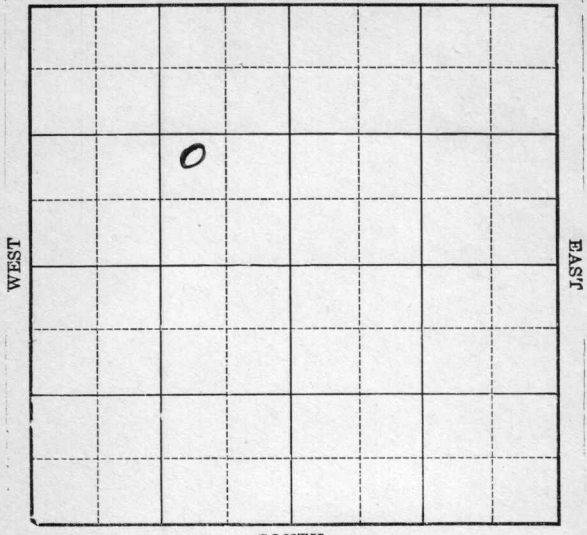

Location \_\_\_\_\_

Drilling Remarks \_\_\_\_\_

Rig Up \_\_\_\_\_

Drilling Remarks \_\_\_\_\_

RECORD

Cased \_\_\_\_\_ in. \_\_\_\_\_ ft.

Sand \_\_\_\_\_

Gas \_\_\_\_\_

Oil \_\_\_\_\_

Total Depth \_\_\_\_\_

PRODUCTION

1st 24 hrs. Nat. \_\_\_\_\_

1st 24 hrs. after shot \_\_\_\_\_

Gas \_\_\_\_\_ cu. ft.

Dry Hole \_\_\_\_\_


Abandoned \_\_\_\_\_

*Hoodson*

Map No. \_\_\_\_\_ Sec. 28 Twp. 24 R. 14E

Well No. 1 Street Farm \_\_\_\_\_  
Sheedy et al Company \_\_\_\_\_

\_\_\_\_\_ Ft. from N. Line  
1070 Ft. from S. Line  
1070 Ft. from E. Line  
\_\_\_\_\_ Ft. from W. Line

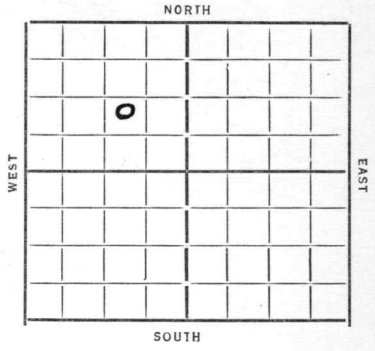

Date  
1954  
5/9  
5/18  
5/30

REPORT

Alg 750  
Top Line 1729 Alg 1875  
TD 1825 D & A

**ABANDONED**

Map No. 17 Sec. 28 Twp. 24 R. 14E

Well No. 1- Street

Sheedy et al Company

Contractor

**SECTION PLAT**

	0		

**FIRST REPORTS**

\_\_\_\_\_ Ft. from N. Line

1070 Ft. from S. Line

1070 Ft. from E. Line

\_\_\_\_\_ Ft. from W. Line

**RECORD**

Location \_\_\_\_\_

Cased \_\_\_\_\_ in., \_\_\_\_\_ ft.

Rig up \_\_\_\_\_

Sand \_\_\_\_\_

Drilling and Remarks:

Gas \_\_\_\_\_

Oil \_\_\_\_\_

Total Depth \_\_\_\_\_

**PRODUCTION**

1st 24 hrs. Nat. \_\_\_\_\_

1st 24 hrs. after shot \_\_\_\_\_

Gas \_\_\_\_\_ Cu. Ft.

Dry Hole \_\_\_\_\_

Abandoned \_\_\_\_\_

Well 750

Date

5-9-34 19

ORVAL MANNSCHRECK Scout

Map No. 17 Sec. 28 Twp. 24 R. 14E

Well No. 1 Street

Sheely & Son Company

Contractor

**SECTION PLAT**

	0		
ABANDONED			

\_\_\_\_\_ Ft. from N. Line

1070 Ft. from S. Line

1070 Ft. from E. Line

\_\_\_\_\_ Ft. from W. Line

Location \_\_\_\_\_

Rig up \_\_\_\_\_

Drilling and Remarks:

IVA

**RECORD**

Cased \_\_\_\_\_ in., \_\_\_\_\_ ft.

Sand \_\_\_\_\_

Gas \_\_\_\_\_

Oil \_\_\_\_\_

Total Depth 1825

**PRODUCTION**

1st 24 hrs. Nat. \_\_\_\_\_

1st 24 hrs. after shot \_\_\_\_\_

Gas \_\_\_\_\_ Cu. Ft.

Dry Hole \_\_\_\_\_

Abandoned \_\_\_\_\_

Date

5/30

1934

**ORVAL MANNSCHRECK**

Scout