


Map No. KANSAS Sec. 29 Twp. 24 R. 14E

Well No. 1-Lawton Farm

Empire & Kelly Company

NORTH

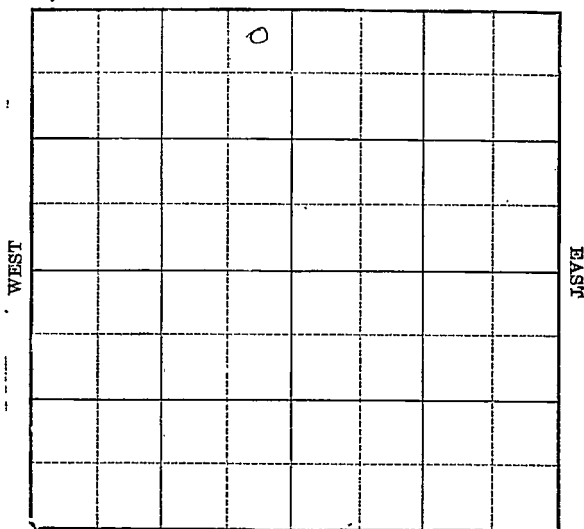

SOUTH

Location \_\_\_\_\_

Drilling Remarks \_\_\_\_\_  
\_\_\_\_\_  
\_\_\_\_\_  
Rig Up \_\_\_\_\_

Drilling Remarks \_\_\_\_\_  
\_\_\_\_\_  
\_\_\_\_\_  
**RECORD**

Cased \_\_\_\_\_ in. \_\_\_\_\_ ft.

Sand \_\_\_\_\_

Gas \_\_\_\_\_

Oil \_\_\_\_\_

Total Depth \_\_\_\_\_

**PRODUCTION**

1st 24 hrs. Nat. \_\_\_\_\_

1st 24 hrs. after shot \_\_\_\_\_

Gas \_\_\_\_\_ cu. ft.

Dry Hole \_\_\_\_\_

Abandoned \_\_\_\_\_

Woodson

Form 252A-5M-11-29-38055

Map No. KANSAS Sec. 29 Twp. 24 R. 14E

Well No. 1- Lawton Farm


Empire & Shelly Company

250 Ft. from N. Line

\_\_\_\_\_ Ft. from S. Line

250 Ft. from E. Line

\_\_\_\_\_ Ft. from W. Line

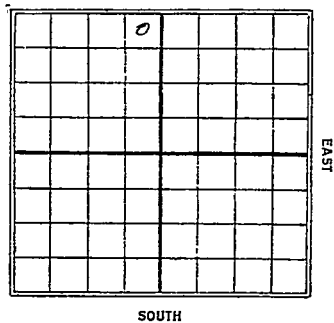

1030

Date	REPORT
8/6	Machine
8/13	T
8/20	Dry 120'
8/27	No " 5496 Hulg 645-
9/3	8" set 1273' Hulg-
9/10	Sdy shale 1587-1600
	" " 1622-62
	Top line 1686
	HFW 1709-20' SD.
9/17	Sdy shale 1587-1600
	Top line 1686
	HFW 1709-20
	T.O. 1720
	Dry & Abandon

*Woodson*

**KANSAS**

No.

Sec.

*29*

Twp.

*24*

R.

*14*

**E**

Well No. *1*

*Rawton*

*Empire & Kelly*

Company

Contractor

### FIRST REPORTS

### SECTION PLAT

250 Ft. from N. Line

\_\_\_\_\_ Ft. from S. Line

250 Ft. from E. Line

\_\_\_\_\_ Ft. from W. Line

		o		

Location \_\_\_\_\_

Rig up \_\_\_\_\_

Drilling and Remarks:

*Machine:*

### RECORD

Cased \_\_\_\_\_ in., \_\_\_\_\_ ft.

Sand \_\_\_\_\_

Gas \_\_\_\_\_

Oil \_\_\_\_\_

Total Depth \_\_\_\_\_

### PRODUCTION

1st 24 hrs. Nat. \_\_\_\_\_

1st 24 hrs. after shot \_\_\_\_\_

Gas \_\_\_\_\_ Cu. Ft.

Dry Hole \_\_\_\_\_

Abandoned \_\_\_\_\_

Date

**AUG 6**

**1930**

**CHAS. L. SHERWOOD**

19

Scout

*Woodson*

17  
Map No. KANSAS Sec. 29 Twp. 24 R. 14

Well No. 1  
Rawston  
Empire & Kelly Company

Contractor

COMPLETE

SECTION PLAT

	o		

250 Ft. from N. Line

\_\_\_\_\_ Ft. from S. Line

250 Ft. from E. Line

\_\_\_\_\_ Ft. from W. Line

ABANDONED

Location \_\_\_\_\_

Rig up \_\_\_\_\_

Drilling and Remarks:

*Sandy shale 1587-1600*  
*Tap line 1686'*  
*HW 1709-20*

RECORD

Cased \_\_\_\_\_ in., \_\_\_\_\_ ft.

Sand \_\_\_\_\_

Gas \_\_\_\_\_

Oil \_\_\_\_\_

Total Depth 1720

PRODUCTION

1st 24 hrs. Nat. \_\_\_\_\_

1st 24 hrs. after shot \_\_\_\_\_

Gas \_\_\_\_\_ Cu. Ft.

Dry Hole

Abandoned

Date

SEP 17 1930

CHAS. L. SHERWOOD

19

Scout