

State Kansas County Barton

Company G*M*R Well No. 1


Farm Fischer

Survey

Block No. Sec. 20 Twp. 20 Range 12

Co-Ord. Elev. 1838 D.F.

NE NE NE

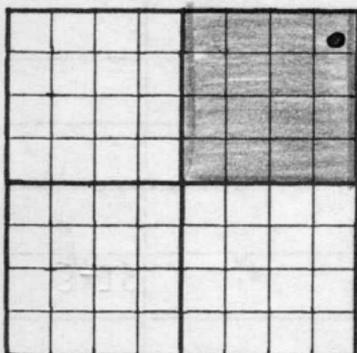

1/4 Graham
3/16 Dale Carnegie
1/16 Dorothy Carnegie
1/2 G M R

NOTE: Show Sketch of Lease and Well Location in Above Space

Ft. from N. Line

Ft. from S. Line

Ft. from W. Line

Ft. from E. Line

Date	Depth	
		2-23 Moving In
2-24		8 5/8" @ 205 w/165 sx.4cc 3ge1
2-25	1612	Drlg.
2-26	2143	Drlg.
2-27	2685	Drlg.
	3036	Heebner
	3159	Br. Lm
	3174	Lansing (-1333)
	D.S.T. 3215-32	Op 45", Rec 5' mud N/S 0 BHP wk. blow for 7"

Date	Depth	712491
3-2	3356	Drlg
3-3	3421	Arbuckle (-1580)
	3428	R.T.D. Fr. por. sat & odor running 5½" @ 3423
3-4		WOC
3-5		W.O.C.T. Call Ted Brooks-
		Beacon
3-14	3442	T.D. Testing 2½ GOPH setting- 4½" line
3-17		Drld plug-swb 3-5 GOPH-dd 3444 to acidize with 250 gal.
3-18		250 gal acid. No incr-to drill deeper
3-19		Drlg. @ 3453-8 gal OPH from 3452-53 still in good dolo.
	3455	T.D. 1000 acid testing 1½
		B OPH continue to test
	3466	T.D. Test 1/2 BOPH plus 1½ BWPB dd
3-23	3507	Hole full of wtr. 3486-88 2bbls wtr/hr. Big incr. in wtr from 3502-07
3-24		Abandoned
3-26		Alpine & Skelly O.K. to plug
	T.D. 3507	

D & A