

Woodson


Form 51-5M-2-29-34703

Map No. KANSAS Sec. 30 Twp. 24 R. 14

Well No. J. J. Collins Farm

Schmole et al Company

NORTH

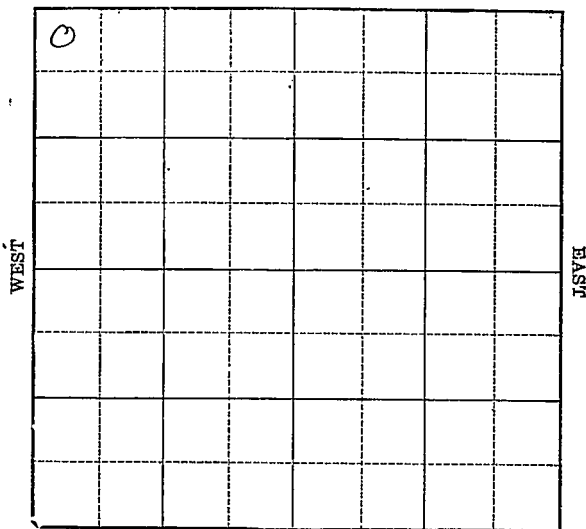

Location \_\_\_\_\_

Drilling Remarks \_\_\_\_\_

\_\_\_\_\_

\_\_\_\_\_

RECORD

Cased \_\_\_\_\_ in. \_\_\_\_\_ ft.

Sand \_\_\_\_\_

Gas \_\_\_\_\_

Oil \_\_\_\_\_

Total Depth \_\_\_\_\_

Rig Up \_\_\_\_\_

Drilling Remarks \_\_\_\_\_

\_\_\_\_\_

\_\_\_\_\_

PRODUCTION

1st 24 hrs. Nat. \_\_\_\_\_

1st 24 hrs. after shot \_\_\_\_\_

Gas \_\_\_\_\_ cu. ft. \_\_\_\_\_

Dry Hole \_\_\_\_\_

Abandoned \_\_\_\_\_

*Woodson*

MAP No. *Kns* SEC. *30* TWP. *74* R. *14*

WELL No. *1 Collins*

*Schmaes et al* COMPANY

CONTRACTOR

FIRST REPORTS  
ABANDONED

SECTION PLAT

\_\_\_\_\_ FT. FROM N. LINE  
\_\_\_\_\_ FT. FROM S. LINE  
\_\_\_\_\_ FT. FROM E. LINE  
\_\_\_\_\_ FT. FROM W. LINE

0			

LOCATION \_\_\_\_\_

RIG UP \_\_\_\_\_

DRILLING AND REMARKS:

*Tap W 1675*  
*SS 1700-08 Strw*

RECORD

CASED \_\_\_\_\_ IN. \_\_\_\_\_ FT.

SAND \_\_\_\_\_

GAS \_\_\_\_\_

OIL \_\_\_\_\_

TOTAL DEPTH *1713*

PRODUCTION

1ST 24 HRS. NAT. \_\_\_\_\_

1ST 24 HRS. AFTER SHOT \_\_\_\_\_

GAS \_\_\_\_\_ CU. FT.

DRY HOLE

ABANDONED

DATE

*6/28/79*

192

*Sherwood*

SCOUT