

KANSAS

Form 51-5M-7-40-Palace


Butler KANSAS

Section 16 Township 29 Range 4-E

Well No. #1 Barnes

Company Ben Gralapp & Baum

NORTH Douglas Pool

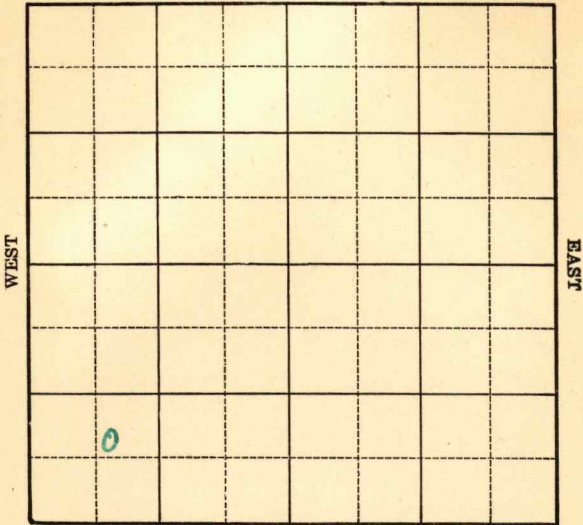

SOUTH

Sec. 16 Twp. 29 R. 4-E

Well No. #1 Barnes Farm

Ben Gralapp & Baum Company


(Douglas)

\_\_\_\_\_ Ft. from N. Line

825 Ft. from S. Line

1815 Ft. from E. Line

\_\_\_\_\_ Ft. from W. Line

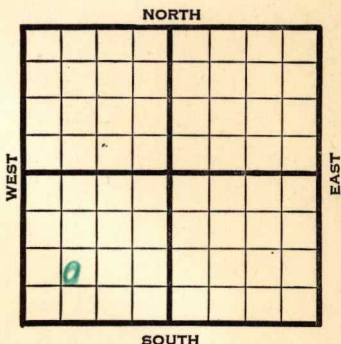

**Elev. 1209**

1940	REPORT
9/4	Machine.
9/12	Rigging up.
9/16	Spud.
9/26	12" - 50' Drlg. 100'
10/3	Shut down.
10/10	SD 700'
10/17	10" - 650' Drlg. 900'
10/24	8" - 1014' Drlg. 1105'
10/31	Drlg. <del>8XX</del> 1375'
11/7	1828' run 6".
11/14	6" - 1835' <b>Lans. 1835'</b> S.O. 1852-69' T.D. 200' oil 100 water 48 hours.
11/21	" " "
11/27	Shut down.
12/5	" "
12/12	" "
12/19	6" - 1860' WOC.
12/26	T.D. 1895'

**OVER**

1941		
1/2	TD 1895'	
1/9	"	
1/16	<b>B.K.C. 1908'</b>	<b>T.D. 1910'</b>
	1500 acid.	
1/23	"	"
1/30	"	"
2/6	Shut down.	
2/13	"	"
2/20	"	"
2/27	"	"
3/6	"	"
3/12	Lans. 1836'	
	<b>B.K.C. 1908'</b>	
	6" - 1860'	
	T.D. 1910'	
	3500 acid.	
	Water.	

**ABANDONED**



Map No. // Sec. 16 Twp. 29 R. 4E

Well No. 1 Barnes

Ben Gralapp & Baum Company

Contractor

ABANDONED

SECTION PLAT

NE SW SW


\_\_\_\_\_ Ft. from N. Line

825 Ft. from S. Line

1815 Ft. from E. Line

\_\_\_\_\_ Ft. from W. Line

Douglas POOL

Location \_\_\_\_\_

Rig up \_\_\_\_\_

Drilling and Remarks:

*4 ans 1836.*  
*B/KC 1908.*  
*6" C 1860*  
*3000 acid*  
*Water.*

RECORD

Cased \_\_\_\_\_ in., \_\_\_\_\_ ft.

Sand \_\_\_\_\_

Gas \_\_\_\_\_

Oil \_\_\_\_\_

Total Depth 1910

PRODUCTION

1st 24 hrs. Nat. \_\_\_\_\_

1st 24 hrs. after shot \_\_\_\_\_

Gas \_\_\_\_\_ Cu. Ft.

Dry Hole \_\_\_\_\_

Abandoned \_\_\_\_\_

Date

MAR 12 1941 19

S. J. LEWIS Scout