


Butler

Form 51-5M-5-34-Palace

Map No. **KANSAS** Sec. *16* Twp. *29* R. *4E*

Well No. *1* *Crude* Farm
Polhamus Company

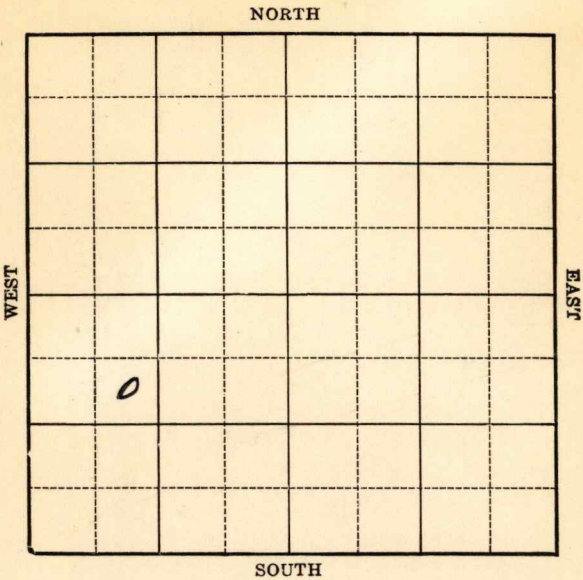

Location _____

Drilling Remarks _____

Rig Up _____

Drilling Remarks _____

RECORD

Cased _____ in. _____ ft.

Sand _____

Gas _____

Oil _____

Total Depth _____

PRODUCTION

1st 24 hrs. Nat. _____

1st 24 hrs. after shot _____

Gas _____ cu. ft.

Dry Hole _____

Abandoned _____

Butler

Map No. Sec. 16 Twp. 29 R. 4E


Well No. 1 *Crude* Farm
Polhamus Company

990 Ft. from N. Line

_____ Ft. from S. Line

_____ Ft. from E. Line

990 Ft. from W. Line

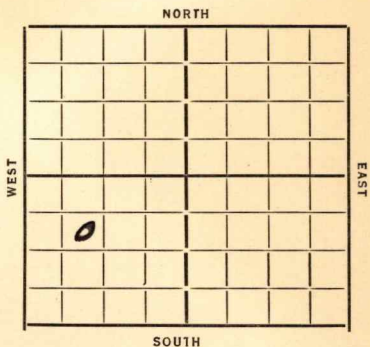

Date	REPORT
<i>11/21</i>	<i>Rign</i>
<i>11/28</i>	<i>Spud</i>
<i>12/6</i>	<i>Dly 122</i>
<i>12/13</i>	<i>_____</i>
<i>12/21</i>	<i>Dly 700</i>
<i>12/27</i>	<i>_____</i>
<i>1/3/35</i>	<i>Dly 1575</i>
<i>1/10</i>	<i>K C 1839 Pay 1857-75</i>
	<i>T 1881 S.O.</i>
<i>1/17</i>	<i>acidizing</i>
<i>1/24</i>	<i>_____</i>
<i>1/31</i>	<i>C.O.</i>
<i>2/7</i>	<i>_____ 2/14 — 2/21 — 2/28</i>
<i>3/7</i>	<i>_____ 3/14 — 3/21</i>
<i>3/27</i>	<i>K C 1839 T 1881</i>
	<i>N. & A.</i>

ABANDONED

Map No. 11 Sec. 16 Twp. 29 R. 4E

Well No. 1- Crude

Polhamus Company

Contractor

FIRST REPORTS

SECTION PLAT

990 Ft. from N. Line

..... Ft. from S. Line

..... Ft. from E. Line

990 Ft. from W. Line

Location.....

Rig up.....

Drilling and Remarks:

Rig in

RECORD

Cased..... in., ft.

Sand.....

Gas.....

Oil.....

Total Depth.....

PRODUCTION

1st 24 hrs. Nat.....

1st 24 hrs. after shot.....

Gas..... Cu. Ft.

Dry Hole.....

Abandoned.....

Date

11-21-34 192.....

ORVAL MANNSCHRECK

Scout

Map No. 11 Sec. 16 Twp. 29 R. 4E

Well No. 1-Creede

Polhamus et al Company
Contractor

ABANDONED

SECTION PLAT

990 Ft. from N. Line

..... Ft. from S. Line

..... Ft. from E. Line

990 Ft. from W. Line

	0		

Location.....

Rig up.....

Drilling and Remarks:

W + A

RECORD

Cased..... in., ft.

Sand K.C. 1839

Gas.....

Oil.....

Total Depth 1888

PRODUCTION

1st 24 hrs. Nat.....

1st 24 hrs. after shot.....

Gas..... Cu. Ft.

Dry Hole.....

Abandoned.....

Date

3-27-35 192.....

ORVAL MANNSCHRECK

Scout