


Butler

KANSAS

SECTION 16 TOWNSHIP 29S RANGE 4E

WELL NO. #1 Harter

COMPANY A.D. Allison

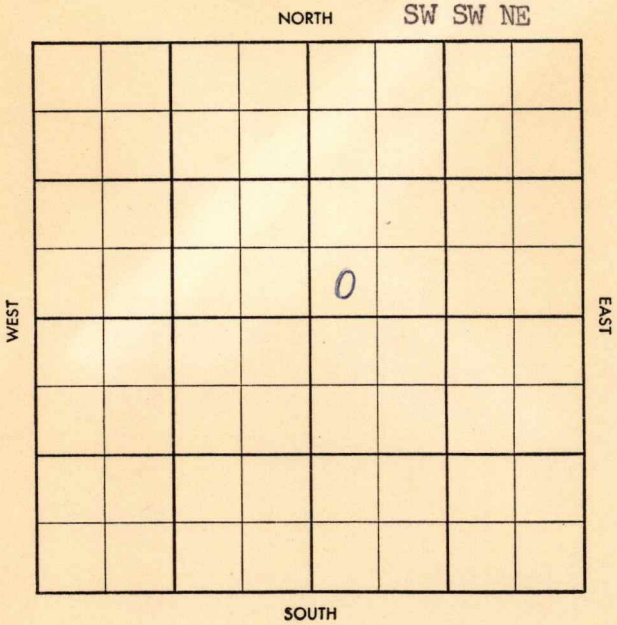

CO. ~~Butler~~ ELEV. 1215  
SEC. 16 TWP. 29 RGE. 4E  
COMPANY A. D. Allison NO. 1

NOV 6 '57  
0  
COMPLETE

FARM Harter

LOC. SW SW NE

L 1798  
~~BK~~ 1960  
KC 2105  
BKC 2321  
A 2646  
TD 2654

GEOL.  
CONTR. G. D. Smitherman  
POOL Asmusson  
SPUD 10 ~~27~~ - 57  
8" @ 200/750  
OCT 23 '57 5 1/2" 2649/100  
OCT 23 '57 NOV 8 '57 CO  
2654 F10 7 1/2 B0  
ph NW nat

D Hy Fls 180 B0 pd NW  
34.6' gw

arb 2649-54

CO.  
LSE  
NO.  
SEC.  
TWP.  
RGE.

