

Map No. KANSAS Sec. 32 Twp 24 R. 14^E
 Well No. 1 - J. F. Ryan Farm _____
Speedy et al Company _____


_____ Ft. from N. Line

1100 Ft. from S. Line

_____ Ft. from E. Line

1100 Ft. from W. Line

1932

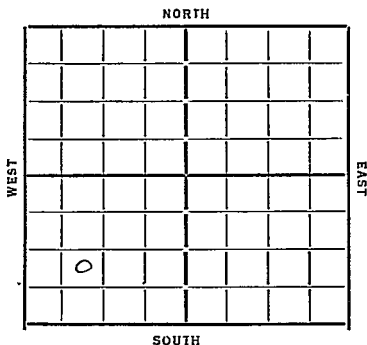

Date	REPORT
11/23	Dreg 260'
11/30	" 900'
12/17	8" - 1294
	Dreg 1360'
12/14	SID 1360'
12/21	—
12/28	Top lime 1701
	TD. 1721
	300 ft water 8 hrs
	Dry & abandon

Woodson

17 **KANSAS** Map No. Sec. *32* Twp. *24* R. *14* E

Well No. *1* *J. J. Ryan* Company

Sheedy & Co Contractor

FIRST REPORTS

..... Ft. from N. Line

1100 Ft. from S. Line

..... Ft. from E. Line

1100 Ft. from W. Line

SECTION PLAT

Location.....

Rig up.....

Drilling and Remarks:

By 260

RECORD

Cased.....in.,ft.

Sand.....

Gas.....

Oil.....

Total Depth.....

PRODUCTION

1st 24 hrs. Nat.....

1st 24 hrs. after shot.....

Gas.....Cu. Ft.

Dry Hole.....

Abandoned.....

Date

NOV 23 1932 **CHAS. L. SHERWOOD**

Woodson

17 KANSAS Map No. Sec. 32 Twp. 24 R. 14 E

Well No. J. F. Ryan

Sheedy et al

Company

Contractor

COMPLETED

SECTION PLAT

.....Ft. from N. Line

1800 Ft. from S. Line

.....Ft. from E. Line

1100 Ft. from W. Line

2			

ABANDONED

Location.....

Rig up.....

Drilling and Remarks:

Top Lens 1701
300 Water 8 Hrs.

RECORD

Cased.....in.,ft.

Sand.....

Gas.....

Oil.....

Total Depth 1721

PRODUCTION

1st 24 hrs. Nat.....

1st 24 hrs. after shot.....

Gas.....Cu. Ft.

Dry Hole..... ✓

Abandoned..... ✓

Date

DEC 28 1932 CHAS. L. SHERWOOD Scout