KANSAS


Ellsworth

FORM 51 5M 4-41 PETROL

Section 32 Township 17 Range 10-W

Well No. 5 Zink

Company Magnolia

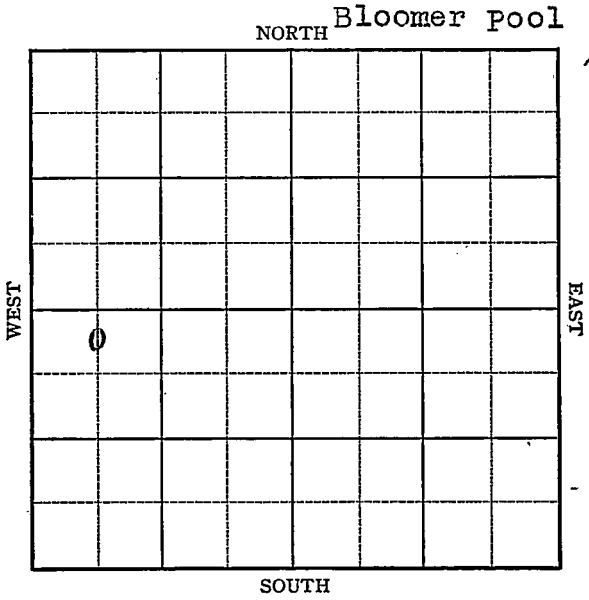

FORM 252-A 5M 6-41 PETROL KANSAS Ellsworth

Sec. 32 Twp. 17 R. 10-W

Well No. #5 Zink Farm

Magnolia Company


(Bloomer)

330 Ft. from N. Line

_____ Ft. from S. Line

_____ Ft. from E. Line

660 Ft. from W. Line

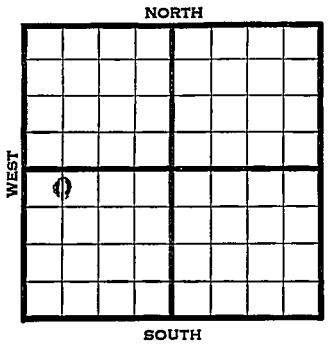

Elev. 1790

1941	REPORT
10/1	Drlg. 210'
10/16	10" - 210' Drlg. 2350'
10/23	Arb. 3234' 5" - 3236'
	T.D. 3239' RUST.
10/30	" " "
11/6	T.D. 3244' 1000 acid.
	Potential 413 bbls., pump.
11/12	Arb. 3234'
	5" - 3236'
	T.D. 3247'
	3000 acid.
	Echometer potential 1096 bbls.
	42.6 Gravity
	COMPLETED

Form 26 200 Bks. 5-41 McW.

Ellsworth KANSAS

Map No. K-55 Sec. 32 Twp. 17 R. 10W

Well No. 5 Zink

Magnolia Company

FIRST REPORT Contractor

C NL NW SW

330 Ft. from N. Line


_____ Ft. from S. Line

_____ Ft. from E. Line

660 Ft. from W. Line

BLOOMER POOL

SECTION PLAT

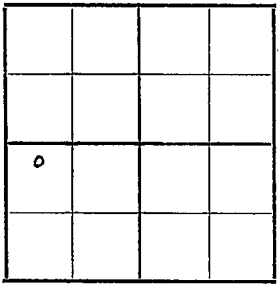

Location _____

Rig up _____

Drilling and Remarks:

Drlg. 210'

RECORD

Cased _____ in., _____ ft.

Sand _____

Gas _____

Oil _____

Total Depth _____

PRODUCTION

1st 24 hrs. Nat. _____

1st 24 hrs. after shot _____

Gas _____ Cu. Ft.

Dry Hole _____

Abandoned _____

Date

OCT 1 1941 19 S. J. LEWIS Scout

Form 26 200 Bks. 5-41 McW.

KANSAS

Ellsworth

Map No. A-51 Sec. 32 Twp. 17 R. 10W

Well No. 5 Zink

Magnolia Company

COMPLETED Contractor

C NL NW SW


330 Ft. from N. Line

____ Ft. from S. Line

____ Ft. from E. Line

660 Ft. from W. Line

SECTION PLAT

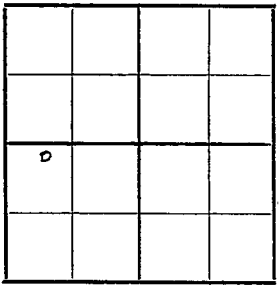

BLOOMER POOL

Location

Rig up

Drilling and Remarks:

RTD 3234

5" @ 3236

8000 Acid

Echo Pt 1096

42 6 Gal

RECORD

Cased ____ in., ____ ft.

Sand

Gas

Oil

Total Depth 3247

PRODUCTION

1st 24 hrs. Nat.

1st 24 hrs. after shot

Gas ____ Cu. Ft.

Dry Hole

Abandoned

Date

NOV 12 1941 19

S. I. LEWIS Scout