


Butler

KANSAS

SECTION 16 TOWNSHIP 29S RANGE 4E

WELL NO. #3 Haskell

COMPANY L.W. Ewalt

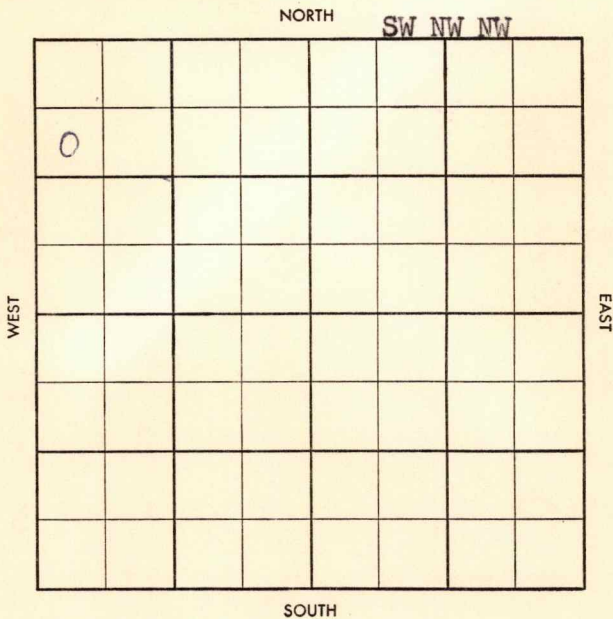

S-513-B

X  
X  
X

County Butler Elev. 1195 RB  
 Sec. 16 Twp. 29 Rge. 4E  
 Company L. W. Ewalt  
 Farm Name Haskell No. 3

TOPS	DEPTH	LOG	DATUM	Loc. in Sec.
Anh.				<u>SW NW NW</u>
Tp.				
H.				
Tr.				
Dg.				
B.L.				
L.	<u>1830</u>			
K.C.				Geol. _____
B.K.C.				Contr. _____
Ce.				<u>Crisswell</u>
C.				Pool _____
M.				<u>Asmusson</u>
Mz.				
Mq.				
V.				
S.				
S.				
A.				<b>FIRST REPORT</b>
R.				
Pf.				
G.				
T.D.				<u>JUL 30 58</u>

Date Comm. 7-23-58

10" @ 195; DST 1845-65 op 60" rec 40' ocm +  
60' sli ocm; BHP 350#; RTD 1885; 7" @ 1885  
w/50

\_\_\_\_\_  
 \_\_\_\_\_  
 \_\_\_\_\_  
 \_\_\_\_\_  
 \_\_\_\_\_

Twp.            Pool             
 Co.            Facet           

S-513-B

County Butler Elev. 1195 RB 11980F  
 Sec. 16 Twp. 29 Rge. 4E  
 Company L. W. Ewalt  
 Farm Name Haskell No. 3

TOPS	DEPTH	LOG	DATUM	Loc. in Sec.
Anh.				Sw. NW. NW
Tp.				
H.				
Tr.				
Dg.				
B.L.				
L.	1830			
K.C.				Geol.
B.K.C.				Contr.
Ce.				Grisswell
C.				Pool
M.				Asmusson
M.				
K.				
Mz.				
Mq.				
V.				
S.				
S.				
A.				
R.				
Pf.				
G.				
T.D.	1885			COMPLETE AUG 27 '58

Date Comm. 7-23-58  
 10" @ 195; DST 1845-65 op 60" rec 40' ocm +  
 60' sli ocm; BHP 350#; RTD 1885; 7" @ 1885  
 w/50 AUG 6 '58 12/1949-51 1500A  
 \$ 30 BHP @ 90% oil pop  
 AUG 13 '58 AUG 20 '58 AUG 27 '58  
 P 25 BHP @ (90% wta)  
 Lsq Pay  
 43°