


Butler

KANSAS

SECTION 16 TOWNSHIP 29S RANGE 4E

WELL NO. #1 Haver

COMPANY A.D. Allison

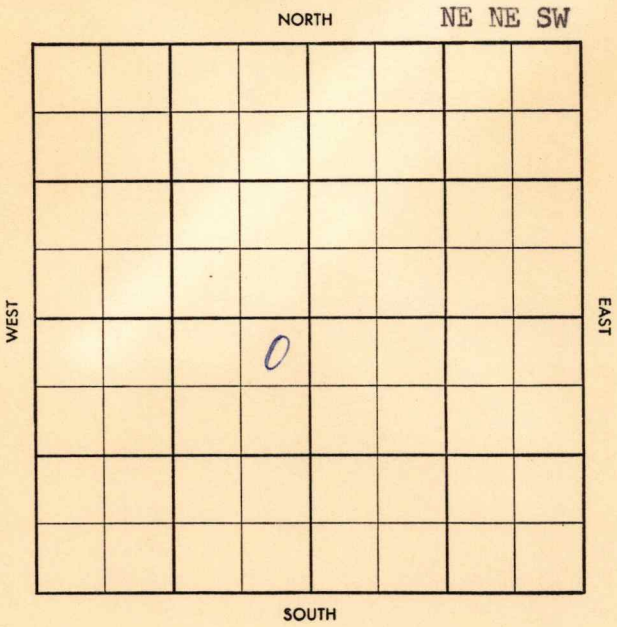

CO. ~~Butler~~ ELEV. 203  
SEC. 16 TWP. 29 RGE. 4E  
COMPANY A. D. Allison NO. 1

COMPLETE

NOV 6 '57

FARM Haver

LOC. NE NE SW

KC 2113  
BKC 2331  
A 2739  
RTD 2745

GEOL. Ray Whorton  
CONTR. G.D. Smitherman tools

POOL Asmussen  
SPUD 9-28-57  
8" @ 124 w/75, LK 1794,  
Drlg. 1960  
5 1/2" 2740

CO 2745 TD  
Fl 20-25 Boph  
thin @ sq Nat

OCT 23 '57 Fl 44 BO ph 34" ch  
~~STPP~~ SICP 90°  
Fl 44 BO ph

PHY Fl 292 BO pd NW  
34.6° N  
arb 2740-45

CO.

USE

NO.

SEC.

TWP.

RGE.

