


Section 36 Township 17 Range 10W

Well No. #1 Sturn

Company G M R

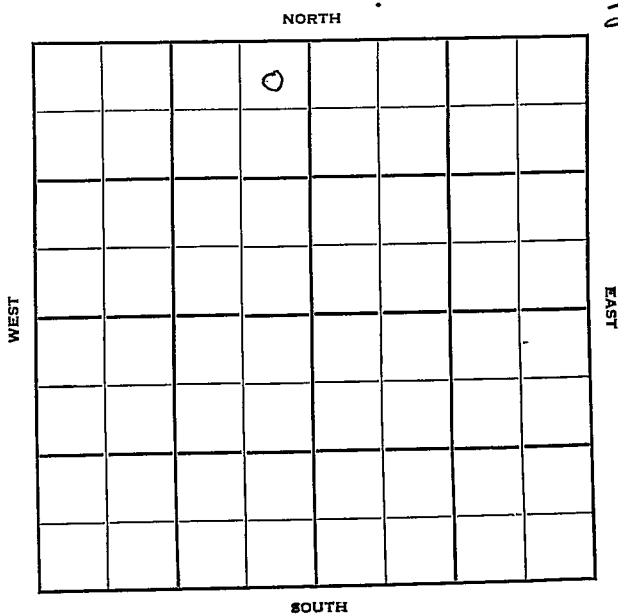

Sec. 36 Twp. 17 R. 10W

Well No. #1 Sturn Farm

G-M-R Company

Contractor


330' Ft. from N. Line

Ft. from S. Line

330' Ft. from E. Line

Ft. from W. Line

NE NE NW

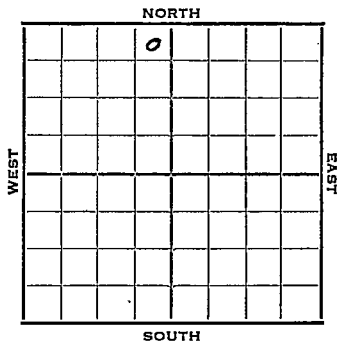

1952 Elev. 1775 REPORT

4/16 Spud 4-2-52
8" @ 250
Br Li 2885 Lans. 2903
DST 2976-96 1 hr. 200' gas & O&GCM
1050#
DST 2990-99 1 hr. 200' wtr 1100#
DST 3190-3230 1 hr. 150' gas
O&GCM 870# Arb. 3257 RTD 3262
5" @ 3259 WOCT

4/23 RTD 3262' 5" @ 3259' WOCT
4/30 NR

5/7 Spud 4-2-52
D & A TD 3270' 8" @ 250
Br. lime 2885' Lans. 2903'
DST 2976-96 open 1 hr. rec 200' gas
& O & GCM
DST 2990-99 open 1 hr, rec 200' water
DST 3190-3230 open 1 hr. rec 150' gas
& O & GCM. Arb. 3257' TD 3262'
5" @ 3259' DD 3263 250 A DD 3270
FU 400' water. 24/3251-57 500 A
20/3221-26 SSO 16/2992-96 2 BWPH
Sq. off 20/2981-86 500 A 10 GO
35 GWPH
D & A

ABANDONED

County **Ellsworth** State **Kansas**

Sec. **36** (Blk. Twp.) **17** (Sur. Rge.) **10W** Map No.

Operator **G-M-R**

Well No. **1** Farm **Sturn**

Elev. **1775** Location **NE NE NW**

FIRST REPORT

330 Ft. From **N** Line **NW**

330 Ft. From **E** Line **Quarter**

1st. Report **APR 16 1952**

Completion

Remarks

Spudding Date **4-2-52**

Drig. Data

8" @ 250 BrL 2885 Lens 2903 DST 2976-96

1 Hr. 200' gas & O&gem 1050# DST 2990-99

1 hr. 200' wtr. 1100# DST 3190-3230 1 hr.

150' gas O&gem 870# Arb 3257 RTD 3262

5" @ 3259 WOCT

J. G. McGEHEE

County Ellsworth State KansasSec. 36 (Blk. Twp.) 17 (Sur. Rge.) 10W Map No.Operator G-M-R OilWell No. 1 Farm SturnElev. 1775 Location NE NE NW

		o			

330 Ft. From N Line NW330 Ft. From E Line Quarter

1st. Report

Completion MAY 7 1952

Remarks

Spudding Date 4-2-52Drlg. Data D & A TD 32708" @ 250 Br. lime 2885 Lans. 2903DST 2976-96 open 1 hr. Rec. 200' gas& o & gcm DST 2990-99 open 1 hr.Rec. 200' water DST 3190-3230 open 1 hr.Rec. 150' gas & o & gcm Arb. 3257TD 3262 5" @ 3259 DD 3263 250 ADD 3270 FU 400' water 24/ 3251-58500 A 20/ 3221-26 SSO 16/ 2992-962 bwph "sq." off 20/ 2981-86 500 A10 go 35 gwphD & A

J. G. McGEHEE