
Form 51-5M-12-36 Com'l KANSAS Ellsworth

Section 33 Township 17 Range 10-W

Well Number #1 Stumps

Company Transwestern

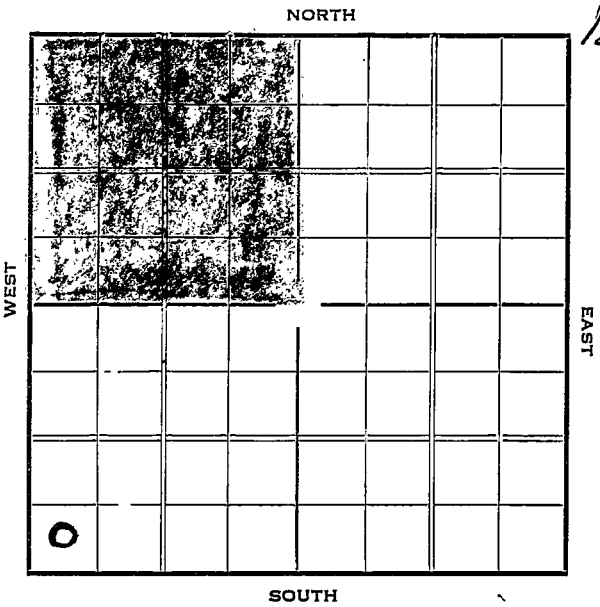


13

Form 252-A—5M—2-37—Palace KANSAS Ellsworth

Sec. 33 Twp. 17 R. 10-W

Well No. #1 Stumps Farm

Transwestern Company

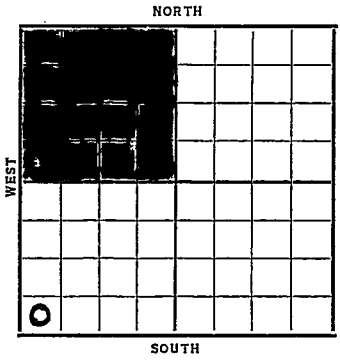

_____ Ft. from N. Line

330 Ft. from S. Line

_____ Ft. from E. Line

330 Ft. from W. Line

Special

Date	Elev. 1775 REPORT
1937	
6/30	Cable rig
7/9	R. U.
7/16	"
7/23	20" @ 83'. Drlg. 235'.
7/30	15" @ 507'. Anhy 520'.
	13" @ 954'. Fsg. @ 1110'.
8/6	10" @ 1885'. Drlg. 2080'.
8/13	10" @ 2193'. Drlg. 2400'.
8/18	Drlg. 3212'. (Tel)
8/19	Top Siliceous 3248 T.D. 3249½
	Running 7" No show (Tel)
8/24	7" 3249 Rainbow show oil 3255-58
	Show oil 3260-62 Show gas 3262-64
	Free oil 3264-66 Filled up 60 feet in
	1 hour Took 1 hour to drill from 3266-
	3267 Total fill up 120 feet
	Shut in Will acidize tomorrow (Tel)
8/25	Filled up 400 feet oil in 18 hrs.
	Acidized 2000 gallons Waiting (Tel)
	OVER

8/27--Top Siliceous 3248 T.D. 3267
Acidized 2000 gallons acid 100 bbl load
Pumped 210 bbls. 15 hours Including load
Now averaging 7 bbls. per hour (Tel)

9/3 " " " "

9/10 " " " "

9/15 7" @ 3249'
Sil 3248'
TD 3267'
2000 acid
P- 84/4 & 87/4
Pot 504 plus 18% water

COMPLETED

Form 26—1M Blks.—2-29 KANSAS Ellsworth

Map No. _____ Sec. 33 Twp. 17 R. 10 W


Well No. 1 — Stumps

Transwestern Company

_____ Contractor

FIRST REPORT

SECTION PLAT

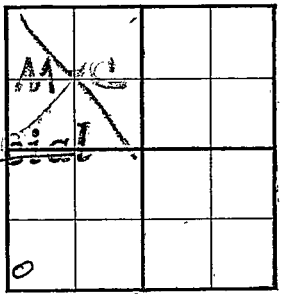

_____ Ft. from N. Line

330 Ft. from S. Line

_____ Ft. from E. Line

330 Ft. from W. Line

Location _____

Rig up _____

Drilling and Remarks:

Cable Rig

RECORD

Cased _____ in., _____ ft.

Sand _____

Gas _____

Oil _____

Total Depth _____

PRODUCTION

1st 24 hrs. Nat. _____

1st 24 hrs. after shot _____

Gas _____ Cu. Ft.

Dry Hole _____

Abandoned _____

Date

JUN 30 1937 19____

H. D. Hatfield Scout

Form 26—1M Bks.—2-29

Ellsworth

Map No. KANSAS Sec. 33 Twp. 17 R. 10 W


Well No. 1 — Stumps

Transwestern Company

Contractor

COMPLETED

SECTION PLAT

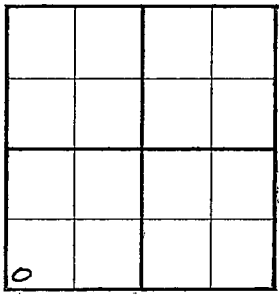

_____ Ft. from N. Line

330 Ft. from S. Line

_____ Ft. from E. Line

330 Ft. from W. Line

Location _____

Rig up _____

Drilling and Remarks:

2000 acid

P - 84/4 + 87/4

Pot 504

Plus 180 water

RECORD

Cased 7 in., 3249 ft.

Sand Sil 3248

Gas _____

Oil _____

Total Depth 3267

PRODUCTION

1st 24 hrs. Nat. _____

1st 24 hrs. after shot _____

Gas _____ Cu. Ft.

Dry Hole _____

Abandoned _____

Date

SEP 15 1937 19

H. D. Hatfield Scout

Atlantic

17'ft thin White

in SW c 28

2' lower than perdue

in SW c 32

Apache well

26' lower than

producer in NE NE SE

26 - 20 - 11

1' higher than wakefield

producer in Sec NW 3

21 - 11