

State Kansas County Cowley

Company Watson Oil Co., Inc. Well No. 2


Farm Nelson

Survey \_\_\_\_\_

Block No. \_\_\_\_\_ Sec. 19 Twp. 33 Range 3E

Co-Ord. \_\_\_\_\_ Elev. 1139 R.B.

*See new map*

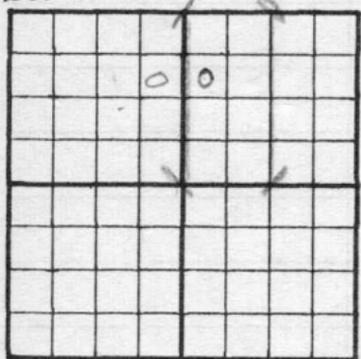

I.O. from:  
 $\frac{1}{2}$  - Chicago Group  
 $\frac{1}{4}$  - E. H. Adams  
 $\frac{1}{4}$  - G.M.R. Prod. Co.  
Subj. to  $\frac{1}{16}$  of  $\frac{1}{8}$  ORR

*To be commenced by 10-13-55*

NOTE: Show Sketch of Lease and Well Location in Above Space

Ft. from N. Line \_\_\_\_\_ Ft. from S. Line \_\_\_\_\_  
Ft. from W. Line \_\_\_\_\_ Ft. from E. Line \_\_\_\_\_

Date	Depth	
		<i>Spd 9-22-55</i>
		<i>8<math>\frac{5}{8}</math>" @ 104'</i>
	<i>3225</i>	<i>R.T.D. 5<math>\frac{1}{2}</math>" @ 3210 w/754p</i>
	<i>2171</i>	<i>Lansing</i>
	<i>2336</i>	<i>Stalnaker</i>
	<i>2600</i>	<i>Lanyon</i>
	<i>2773</i>	<i>K.C.</i>
	<i>2966</i>	<i>Aswego</i>
	<i>3070</i>	<i>Cherokee</i>
	<i>3209</i>	<i>Burtleville</i>

*f. pow. gd 50.00 gd today*

712665

Date

Depth

Cleaned out to 3225  
Trace

Potential = 25 mgpd.