

State Kansas County Decatur


Company Lohmann-Johnson Well No. 1

Farm Feley (Feely)

Survey

Block No. Sec. 27 Twp. 5 Range 27

Co-Ord. Elev. 2664 K.B.

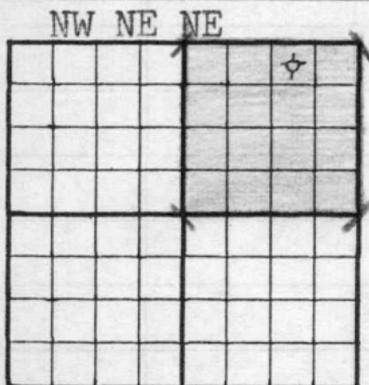

1/3 - Wm. L. Graham  
1/3 - G-M-R Drlg. Co.  
1/3 - Lohmann-Johnson

Geologist: Bob Frensley

NOTE: Show Sketch of Lease and Well Location in Above Space

Ft. from N. Line

Ft. from S. Line

Ft. from W. Line

Ft. from E. Line

Date	Depth	
		8 5/8" @ 195' W/150 sx.cem.
6-1-53		S.U.S.
6-2	1875	Drilling
6-3	2700	"
6-4	3081	" (lost circulation)
6-5	3340	"
	2260	Anhydrite (+398)
	3464	Topeka (-800)
	3651	Heebner (-987)
	3671	Toronto (-1007)

