


Section 17 Township 29 Range 4E

Well No. #2 Creed

Company L. & M. Oil
~~Plymate & Bernholdt~~

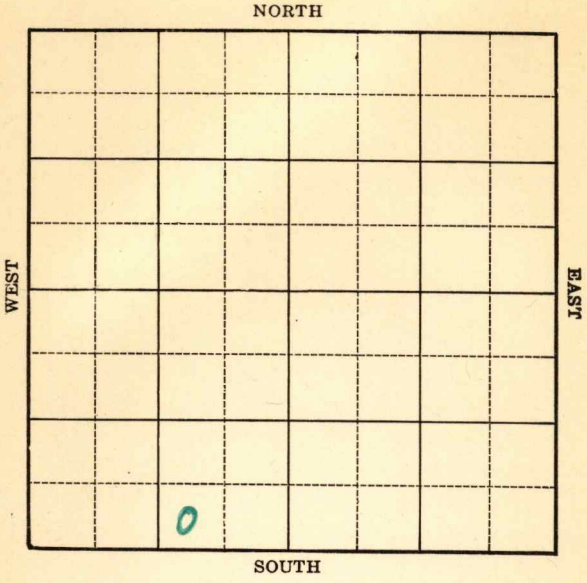

Sec. 17 Twp. 29 R. 4-E

Well No. #2 Creed Farm

L. & M. Oil
Plymate & Bornholdt

Company


(Douglas)

_____ Ft. from N. Line

330 Ft. from S. Line

_____ Ft. from E. Line

990 Ft. from W. Line

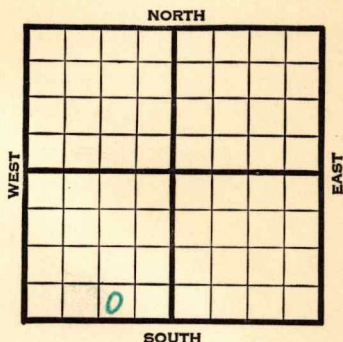

Elev. 1190

| REPORT | |
|--------|--------------------------------|
| 1940 | |
| 10/16 | Machine. |
| 10/24 | Rigging up. |
| 10/31 | " " |
| 11/7 | Drlg. 360' |
| 11/14 | 12" - 420' Drlg. 970' |
| 11/21 | 10" - 1121' Drlg. 1545' |
| 11/27 | Lans. 1860-65' T.D. 7" - 1865' |
| | WOC. |
| 12/5 | 1887' SO. C.O. |
| 12/12 | T.D. 1887' 2000 acid. |
| 12/18 | Lans. 1860' |
| | 7" - 1865' |
| | 2000 acid. |
| | T.D. 1887' |
| | Pump 25 bbls. |
| | 36. Gravity |
| | COMPLETED |

Map No. // Sec. 17 Twp. 29 R. 4E

Well No. 2 Creed

Plymate & Bornholdt Company

Contractor

FIRST REPORT

SECTION PLAT

SW SE SW

_____ Ft. from N. Line

330 Ft. from S. Line

_____ Ft. from E. Line

990 Ft. from W. Line

| | | | |
|--|--|--|--|
| | | | |
| | | | |
| | | | |
| | | | |

DOUGLAS POOL

Location _____

Rig up _____

Drilling and Remarks:

Machine

RECORD

Cased _____ in., _____ ft.

Sand _____

Gas _____

Oil _____

Total Depth _____

PRODUCTION

1st 24 hrs. Nat. _____

1st 24 hrs. after shot _____

Gas _____ Cu. Ft.

Dry Hole _____

Abandoned _____

Date

OCT 16 1940 19

S. J. LEWIS Scout

Map No. 11 Sec. 17 Twp. 29 R. 4E

Well No. 2 Creed

L & M Oil Company

CORRECTION Contractor

SW SE SW

 Ft. from N. Line

330 Ft. from S. Line

 Ft. from E. Line

990 Ft. from W. Line

SECTION PLAT

| | | | |
|--|--|--|--|
| | | | |
| | | | |
| | | | |
| | | | |

DOUGLAS POOL

Location

Rig up

Drilling and Remarks:

This lease has
been sold to the
L & M Oil Co.

RECORD

Cased in., ft.

Sand

Gas

Oil

Total Depth

PRODUCTION

1st 24 hrs. Nat.

1st 24 hrs. after shot

Gas Cu. Ft.

Dry Hole

Abandoned

Date

OCT 24 1940

19

S. J. LEWIS

Scout

Map No. 11 Sec. 17 Twp. 29 R. 4E

Well No. 2 Creed

L & M Oil

Company

Contractor

COMPLETED

SW SE SW

SECTION PLAT

| | | | |
|--|--|--|--|
| | | | |
| | | | |
| | | | |
| | | | |

_____ Ft. from N. Line

330 Ft. from S. Line

_____ Ft. from E. Line

990 Ft. from ^E~~W~~ Line

DOUGLAS POOL

Location _____

Rig up _____

Drilling and Remarks:

Lane 1860
7" @ 1865
2000 axial
Pump 25 1/2 hp
86 @ Gr

RECORD

Cased _____ in., _____ ft.

Sand _____

Gas _____

Oil _____

Total Depth 1887

PRODUCTION

1st 24 hrs. Nat. _____

1st 24 hrs. after shot _____

Gas _____ Cu. Ft.

Dry Hole _____

Abandoned _____

Date

DEC 18 1940 19

S. J. LEWIS

Scout