


Section 17 Township 29 Range 4 E

Well No. # 3 Creed

Company White & Ellis

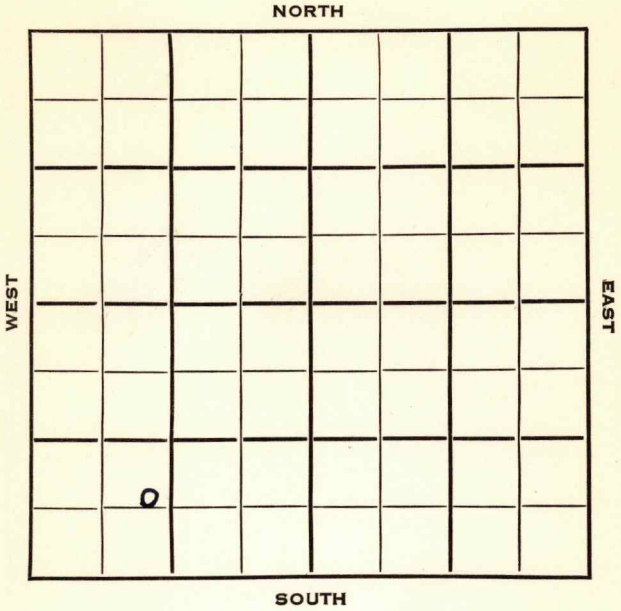

Sec. 17 Twp. 29 R. 4 E

Well No. # 3 Creed Farm

White & Ellis Company

White & Ellis Contractor


 Ft. from N. Line

700 Ft. from S. Line

 Ft. from E. Line

1180 Ft. from W. Line

C E L SW SW

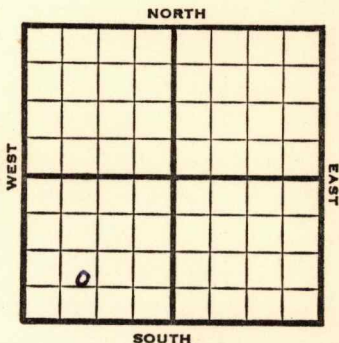

1953

Elev. - REPORT

5/13

Spud 5-6-53
8" @ 65 **Lans 1862'**

6/17

TD 1872 5" @ 1864
Spud 5-6-53 D & A TD 1872
8" @ 65 **Lans 1862** TD 1872
5" @ 1864 CO to 1872 500 A
S/9 BWPB SO
D & A

ABANDONED

County Butler State Kansas

Sec. 17 (Blk. 29 (Sur. 4E Map No. (Twp.) (Rge.))

Operator White & Ellis

Well No. 3 Farm Creed

Elev. _____ Location C E L S W S W

700 Ft. From S Line SW

1180 Ft. From W Line Quarter

1st. Report _____

Completion JUN 17 1953

Remarks _____

White & Ellis - Contr.

Spudding Date 5-6-53

Drilg. Data D & A TD 1872

8" @ 65 Lans. 1862 TD 1872 5" @ 1864

CO to 1872 500 A S/ 9 bwph SO

D & A