


KANSAS

FORM 51 5M BR1X

Section 2 Township 24 Range 15E

Well No. #6 Hancock

Company Jensen et al

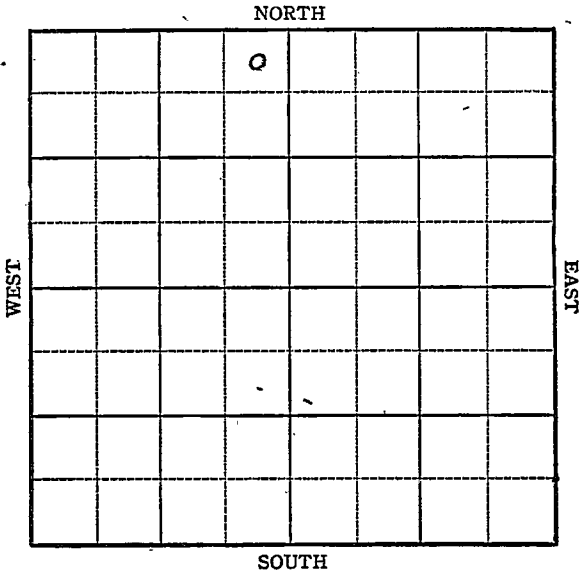

Sec. 2 Twp. 24 R. 15E

Well No. #6 Hancock Farm
Jensen et al Company


Wissman

300 Ft. from N. Line

 Ft. from S. Line

300 Ft. from E. Line

 Ft. from W. Line

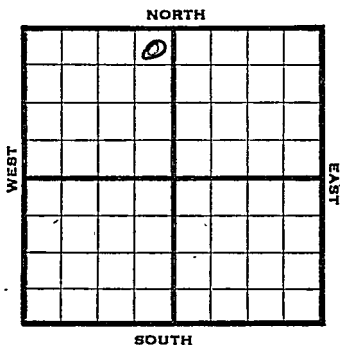

NE NW

1945 REPORT

- 1/31 660' E #5
Machine
- 2/7, Spud
- 2/14 8" @ 797 Drlg
- 2/21 Miss 1493
TD 1508 $\frac{1}{2}$ S gas. Run 6"
- 2/28 Miss 1493
6" @ 1508 $\frac{1}{2}$
TD 1549 $\frac{1}{2}$

ABANDONED

Pool Name Wiseman

KANSAS

Map No. K-17 Sec. 2 Twp. 24 R. 15E

Well No. 6 Hancock

Jensen et al Company

FIRST REPORT

Contractor

NE NW

SECTION PLAT

		o	

300 Ft. from N. Line

_____ Ft. from S. Line

300 Ft. from E. Line

_____ Ft. from W. Line

Woodson

Location _____

Rig up _____

Drilling and Remarks:

660' E #5
machine

RECORD

Cased _____ in., _____ ft.

Sand _____

Gas _____

Oil _____

Total Depth _____

PRODUCTION

1st 24 hrs. Nat. _____

1st 24 hrs. after shot _____

Gas _____ Cu. Ft.

Dry Hole _____

Abandoned _____

Date

JAN 31 1945

19

S. J. LEWIS

Scout

Pool Name WissmanMap No. 17 Sec. 2 Twp. 24 R. 15EWell No. 6 HancockJensen etal CompanyABANDONED Contractor

NE NW

300 Ft. from N. Line Ft. from S. Line300 Ft. from E. Line Ft. from W. Line

SECTION PLAT

Woodson

Location _____

Rig up _____

Drilling and Remarks:

Miss 1499
6" C 1508 1/2

RECORD

Cased _____ in., _____ ft.

Sand _____

Gas _____

Oil _____

Total Depth 1549 1/2

PRODUCTION

1st 24 hrs. Nat. _____

1st 24 hrs. after shot _____

Gas _____ Cu. Ft.

Dry Hole _____

Abandoned _____

Date

FEB 28 1945 19S. I. LEWIS Scout