


KANSAS Woodson County

Section 2 Township 24 Range 15E

Well No. #2 Hancock

Company J. C. Jensen

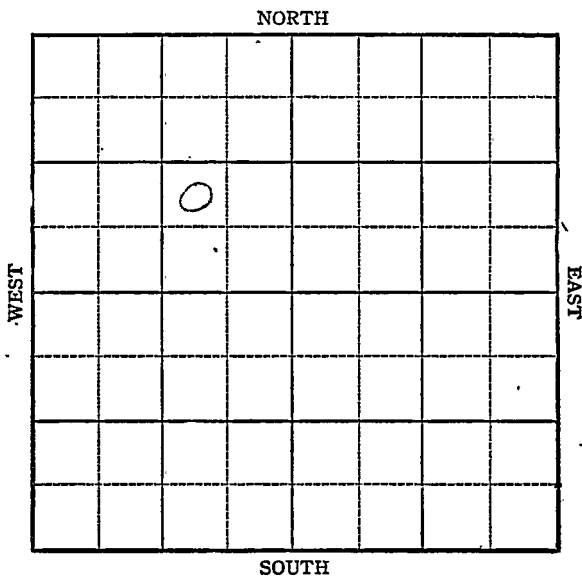

KANSAS Woodson County

Sec. 2 Twp. 24 R. 15E

Well No. #2 Hancock Farm

J. C. Jenson Company


Miscellaneous

         Ft. from N. Line

990 Ft. from S. Line

990 Ft. from E. Line

         Ft. from W. Line

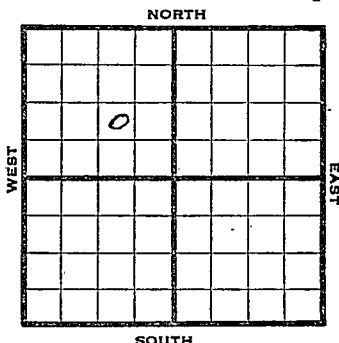

NW SE NW

1944

R E P O R T

10/18

Machine

10/25

10" 23  
Drlg. 450

11/1

Drlg. 650

11/8

8" @ 803  
Drlg. 1490

11/15

Miss 1495  
6" @ 1523  
2000 acid  
TD 1525'  
Pump 75 pot.  
Grav. 36.3

**COMPLETED**



