


Section 2 Township 24 Range 15E

Well No. #4 Hancock

Company J. C. Jenson etal

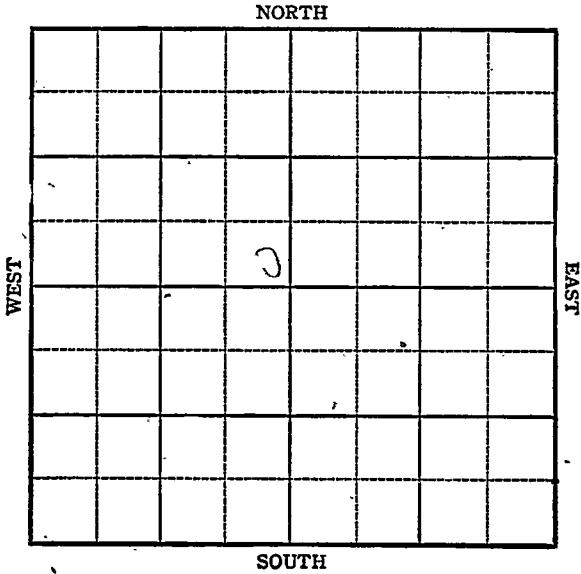


Sec. 2 Twp. 24 R. 15E

Well No. 4 Hancock Farm

J.C. Jenson Etal Company

Yates Center

\_\_\_\_\_ Ft. from N. Line  
200 Ft. from S. Line  
200 Ft. from E. Line  
 \_\_\_\_\_ Ft. from W. Line

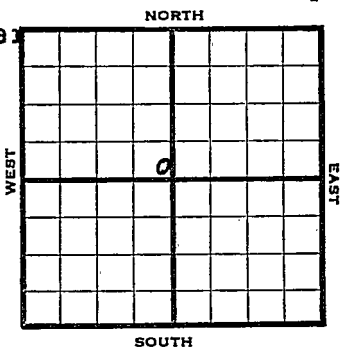

SE NW

1944

R E P O R T

11/22 10" @ 23'  
610'  
 11/29 Drlg. 775  
 12/6 Drlg. 1350'  
8" @ 807  
 12-13 Mississippi 1495'  
6" @ 1495'  
Total Depth 1552'

**ABANDONED**

Pool Name Yates Center

Map No. 17 Sec. 2 Twp. 24 R. 15E

Well No. 4 Hancock

J. C. Jenson et al Company

FIRST REPORT Contractor

SE NW


SECTION PLAT

         Ft. from N. Line

200 Ft. from S. Line

200 Ft. from E. Line

         Ft. from W. Line

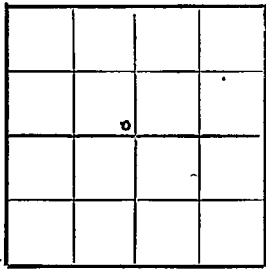

Woodson

Location                                 

Rig up                                 

Drilling and Remarks:

10" - 23'  
610'

RECORD

Cased          in.,          ft.

Sand                                 

Gas                                 

Oil                                 

Total Depth                         

PRODUCTION

1st 24 hrs. Nat.                         

1st 24 hrs. after shot                         

Gas                                  Cu. Ft.

Dry Hole                                 

Abandoned                                 

Date

NOV 22 1944 19

S. J. LEWIS Scout

Pool Name WissmanMap No. 17 Sec. 2 Twp. 24 R. 15EWell No. 4 HancockJ. C. Jensen et al Company**ABANDONED**

Contractor

SE NW

## SECTION PLAT


\_\_\_\_\_ Ft. from N. Line

200 Ft. from S. Line200 Ft. from E. Line

\_\_\_\_\_ Ft. from W. Line

Woodson County

Location \_\_\_\_\_

Rig up \_\_\_\_\_

Drilling and Remarks:

*Miss 1495**6" C/1495*

## RECORD

Cased \_\_\_\_\_ in., \_\_\_\_\_ ft.

Sand \_\_\_\_\_

Gas \_\_\_\_\_

Oil \_\_\_\_\_

Total Depth 1552

## PRODUCTION

1st 24 hrs. Nat. \_\_\_\_\_

1st 24 hrs. after shot \_\_\_\_\_

Gas \_\_\_\_\_ Cu. Ft.

Dry Hole \_\_\_\_\_

Abandoned \_\_\_\_\_

Date

DEC 13 1944 19

S. J. LEWIS Scout

1st report shows this well in SE NW -  
200' from S Line and 200' from E Line.

Betty Turner

Misc. Small Maps	LR
Cards	Betty
Tracing	LR
France Map	✓
Scarborough Map	LR
Pierce Map	✓
Geological Dept.	
Pierce Fr. & Cook	