

KANSAS


Woodson County

FORM 51 5M BR1X

Section 2 Township 24S Range 15E
~~10E~~

Well No. #5 Hancock

Company Jensen et al

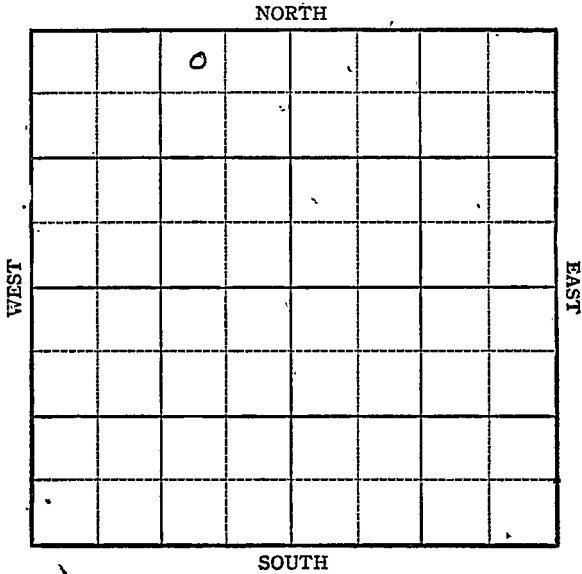

Sec. 2 Twp. 24 R. 15E

Well No. #5 Hancock Farm

Jensen etal Company


Wis sman

300 Ft. from N. Line

_____ Ft. from S. Line

960 Ft. from E. Line

_____ Ft. from W. Line

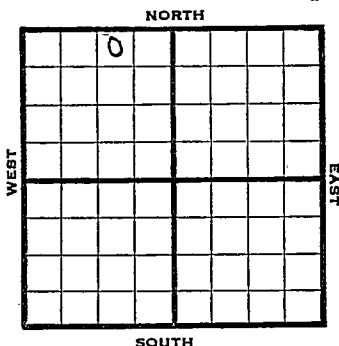

NW NE NW

1944

R E P O R T

12/27	Machine
<u>1945</u>	
1/3	"
1/10	"
1/17	10" @ 23' Drlg 650
1/26	8" @ 791' Drlg. 1485'
1/31	Miss. 1491 TD 1543 1/2

ABANDONED

Pool Name WissmanMap No. 17 Sec. 2 Twp. 24 R. 15EWell No. 5 HancockJensen et al.

Company

FIRST REPORT

Contractor

NW NE NW

SECTION PLAT

	0		

300 Ft. from N. Line Ft. from S. Line960 Ft. from E. Line Ft. from W. LineWoodson CountyLocation Rig up

Drilling and Remarks:

Machine**RECORD**Cased in., ft.Sand Gas Oil Total Depth **PRODUCTION**1st 24 hrs. Nat. 1st 24 hrs. after shot Gas Cu. Ft.Dry Hole Abandoned

Date

DEC 27 194419S. I. LEWIS

Scout

Pool Name Wissman

Map No. K-17 Sec. 2 Twp. 24 R. 15E

Well No. 5 Hancock

Jensen et al Company

ABANDONED Contractor

NW NE NW

SECTION PLAT

300 Ft. from N. Line

_____ Ft. from S. Line

960 Ft. from E. Line

_____ Ft. from W. Line

	6		

Woodson

Location _____

Rig up _____

Drilling and Remarks:

Nov 14 91

RECORD

Cased _____ in., _____ ft.

Sand _____

Gas _____

Oil _____

Total Depth 1543

PRODUCTION

1st 24 hrs. Nat. _____

1st 24 hrs. after shot _____

Gas _____ Cu. Ft.

Dry Hole _____

Abandoned _____

Date

JAN 31 1945

S. J. LEWIS

Scout