


KANSAS

Woodson County

Section 2 Township 24 Range 15E

Well No. #1 Shovel

Company J. C. Jensen

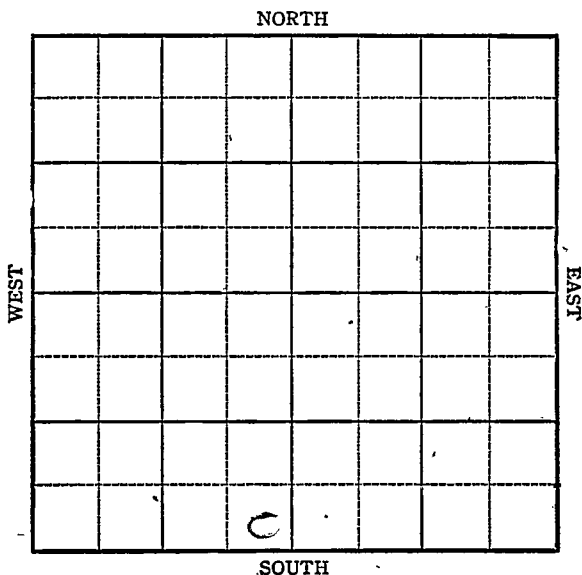

KANSAS

Woodson County

Sec. 2 Twp. 24 R. 15E

Well No. #1 Shovel Farm

J. C. Jensen Company


Woodson

 Ft. from N. Line

330 Ft. from S. Line

330 Ft. from E. Line

 Ft. from W. Line

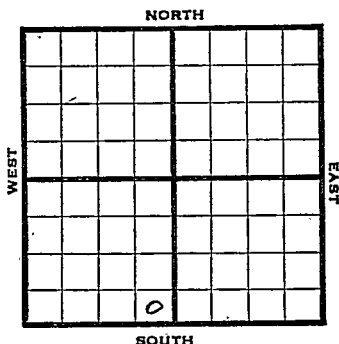

SE SW

1944

R E P O R T

11/8 10" @ 221'
Drlg. 340'

11/16 Drlg. 707'

11/24 8" @ 820 Miss 1512-1520T TD run 6"

11/29 Miss. 1512
7" @ 1520'
TD 1527
Pump 15.Pot.
Gravity 37.4

COMPLETED

Pool Name WissmanMap No. 17 Sec. 2 Twp. 24 R. 15^EWell No. 1 ShovelJ. C. Jensen

Company

COMPLETED

Contractor

SE SW

SECTION PLAT

 Ft. from N. Line330 Ft. from S. Line330 Ft. from E. Line Ft. from W. Line

WoodsonLocation Rig up

Drilling and Remarks:

*Mias 1512**7" @ 1520**Pump 15 Pst**87 1/2 G***RECORD**Cased in., ft.Sand Gas Oil Total Depth 1527**PRODUCTION**1st 24 hrs. Nat. 1st 24 hrs. after shot Gas Cu. Ft.Dry Hole Abandoned

Date

NOV 29 1944 19S. J. LEWIS Scout