

KANSAS


Woodson County

Section 2 Township 24 Range 15E  
~~14E~~

Well No. #2 Switzer

Company Ed Dunn

Yates Center

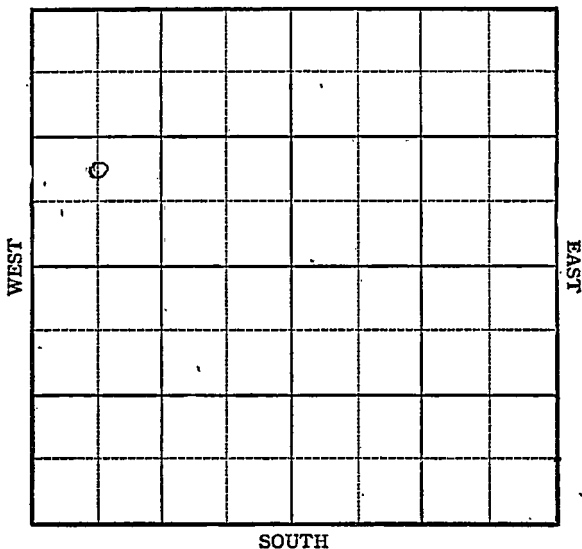

KANSAS

Woodson County

Sec. 2 Twp. 24 R. 15E  
~~14E~~

Well No. #2 Switzer Farm

Ed Dunn Company


Yates Center

\_\_\_\_\_ Ft. from N. Line

990 Ft. from S. Line

\_\_\_\_\_ Ft. from E. Line

660 Ft. from W. Line

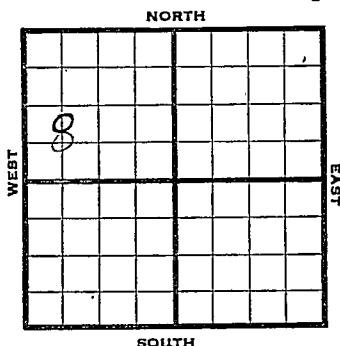

CNL SW NW

1944

R E P O R T

10/25	Machine
11/1	"
11/8	"
11/16	10" @ 38' Drlg. 320'
11/24	S D
11/29	8" @ 805 Drlg1 910
12/6	950 SD
12/14	Drlg. 1418'
12/21	1418' S.D.
12/29	Miss 14944 TD 1523 5" @ 1507' WOC
<u>1945</u>	
1/3	" " "
1/10	TD 1524 fsg
1/17	" " "
1/24	Miss. 1494 5" @ 1507 2000 acid. TD 1524 Pump 40 Pot. Grav. 36.0

COMPLETED

KANSAS

Pool Name Yates CenterMap No. 17 Sec. 2 Twp. 24 R. 14EWell No. 2 SwitzerEd Dunn Company

FIRST REPORT Contractor

C N L SW NW

## SECTION FLAT

         Ft. from N. Line990 Ft. from S. Line         Ft. from E. Line660 Ft. from W. Line

o			

Woodson

## RECORD

Location                                 Cased          in.,          ft.Rig up                                 Sand                                 

Drilling and Remarks:

Gas                                 Machine                                 Oil                                 Total Depth                         

## PRODUCTION

1st 24 hrs. Nat.                         1st 24 hrs. after shot                         Gas                          Cu. Ft.Dry Hole                                 Abandoned                                 

Date

OCT 25 1944

19

S. J. LEWIS Scout

Pool Name Yates Center

Map No. 17 Sec. 2 Twp. 24 R. 15E

Well No. 2 Switzer

Ed Dunn Company

**CORRECTION** Contractor

C <sup>N</sup> L SW NW

**SECTION PLAT**

o			

         Ft. from N. Line

990 Ft. from S. Line

         Ft. from E. Line

660 Ft. from W. Line

Woodson

Location         

Rig up         

Drilling and Remarks:

Reported  
2-24-14E

**RECORD**

Cased          in.,          ft.

Sand         

Gas         

Oil         

Total Depth         

**PRODUCTION**

1st 24 hrs. Nat.         

1st 24 hrs. after shot         

Gas          Cu. Ft.

Dry Hole         

Abandoned         

Date

NOV 8 1944 19

S. J. LEWIS Scout

